


CERTIFIED RECORD OF LAND CORNER MONUMENTATION

X-25

History of original corner establishment:

Corner was established by Deputy Eugene P. McCornack in 1881, contract #398. Set: Basalt stone 20"x16"x10", 1/4 on West. Marked: 8" Juniper S80E--80 lks.; 10" Juniper N40W--59 lks.

Corner was monumented by BLM in 1972 from original evidence. See record field notes.

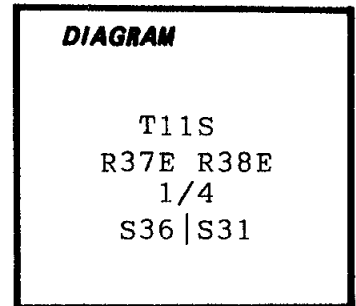

Description of corner evidence found:

BLM iron post with a 3" brass cap firmly set in a mound of stone 3½' base. Stamped:

T11S
R37E R38E
1/4
S36 | S31
1972

Orig. 10" now 12" juniper N39W--38.6'(record N40W--59 lks.)
Scribing visible on open double blaze.

Orig. 8" now 8" Juniper S77E--52.2'(record S80E--80 lks.) Scribing visible on open double blaze.

BLM BT has been bulldozed out of position.


Description of monument and accessories | established to perpetuate the original location of this corner:

Chiseled BX0 on top of 2'x2'x1' high boulder N54¼E--9.6'


Chiseled BX0 on top of 3'x2'x1' high boulder S13 3/4E--22.6'

Nailed 54-9 and 54-3 signs to BT's, painted bands, blazes and chisel marks red. Set guard posts North and West with 54-2 signs, one with 54-9 sign.

Bearings are true by instrument tie.

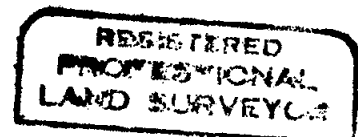

Larry D. Bishop

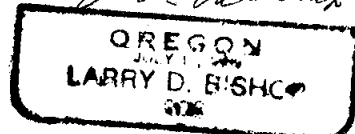

Expires 12/31/95

Office of..... County of.....

State of....., I hereby certify that the within instrument was filed in this office for record on the..... day of....., 19.....

..... by
(COUNTY OFFICIAL) (DEPUTY)