

CERTIFIED RECORD OF LAND CORNER MONUMENTATION

Y-18

History of original corner establishment:

N/A

DIAGRAM

T11S R37E
SW 1/16
S35

Description of corner evidence found:

N/A

Description of monument and accessories established to perpetuate the original location of this corner:


T11S R37E
SW 1/16
S35
1995
LS 896

Set: 2½"x30" alum. pipe with a 3" alum. cap 26" in ground.
Stamped:


Marked:

14" Juniper N43¼W--2.4' Scribed SW 1/16 S35 BT.
11" Ponderosa Pine S64¼W--8.4' Scribed SW 1/16 S35 BT.
Nailed 54-9 and 54-3 signs to BT's, painted bands and blazes red and nailed a 1" brass disk stamped PLS 896 flush between the B and T.
Set guard posts East and West with 54-2 signs, one with 54-9 sign.

Bearings are true by instrument tie.

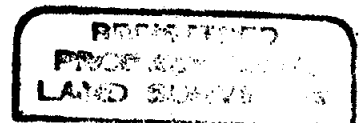

Larry D. Bishop

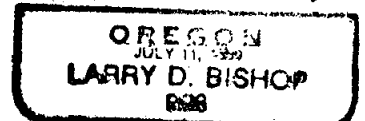

Expires 12/31/95

Office of..... County of.....
State of....., I hereby certify that the within instrument was filed in this office
for record on the..... day of....., 19.....

..... by
(COUNTY OFFICIAL) (DEPUTY)

Form R6-7100-57 (9/71)

FILED FEB. 4, 1998

BAKER COUNTY SURVEYOR

SURVEY NO. 11-37-138

*GPO-591-971, 1988