


History of original corner establishment:

Corner was established by Deputy Eugene P. McCornack in 1881, contract #398. Set: Post, Raised mound of stone alongside. Marked: 14" Pine N82½E--165 lks.; 12" Pine S75E--200 lks.

Corner was monumented by BLM in 1974 from original evidence. See record field notes.

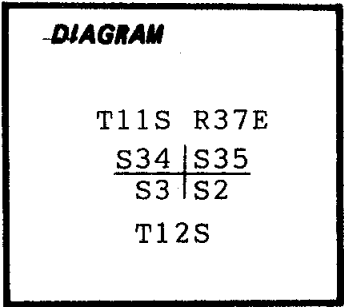

Description of corner evidence found:

BLM iron post with a 3" brass cap firmly set 10" above ground in a small mound of stone. Stamped:

Orig. 14" now down rotted 24" Ponderosa Pine N82½E--108.9' Axe marks on open burned face.


Orig. 12" now 18" Ponderosa Pine stub 15' tall S65 3/4E--132.0' (record S65E) Scribing visible on opened blaze.

T11S R37E
S34 | S35
S3 | S2
T12S
1974

Description of monument and accessories | established to perpetuate the original location of this corner:

Set reference monuments, 5/8"x30" iron rods with 2" alum. caps:
(1) N41W--58.1' Stamped: RM T11S R37E S34, 1995, LS 896, S41E--58.1'.
(2) N66½E--38.5' Stamped: RM T11S R37E S35, 1995, LS 896, S66½W--38.5'.
(3) S29½W--70.8' Stamped: RM T12S R37E S3, 1995, LS 896, N29½E--70.8'.
(4) S51 3/4E--82.6' Stamped: RM T12S R37E S2, 1995, LS 896, N51 3/4W--82.6'.
Nailed 54-9 and 54-3 signs to BT's, painted bands and blazes red.
Set guard post North with 54-9 sign.

Bearings are true by instrument tie.

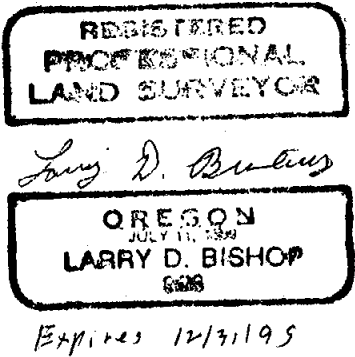

Office of..... County of.....
State of....., I hereby certify that the within instrument was filed in this office
for record on the..... day of....., 19.....
..... by
(COUNTY OFFICIAL) (DEPUTY)

FILED FEB. 4, 1998
BAKER COUNTY SURVEYOR
SURVEY NO. 11-37-141
12-37-68