


CERTIFIED RECORD OF LAND CORNER MONUMENTATION

Z-19

History of original corner establishment:

Corner was established by Eugene P. McCornack in 1881, contract #398. Set: Wood post. Marked: 24" Pine N40W-19 lks.; 30" Pine S85E--25 lks..

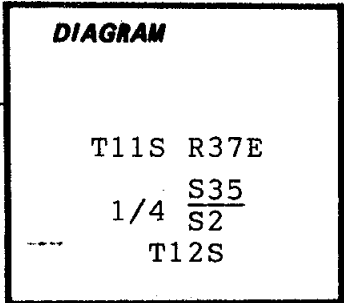

Description of corner evidence found:

Searched for, not found.

Description of monument and accessories established to perpetuate the original location of this corner:

At proportion set 2 1/2"x30" alum. pipe with a 3" alum. cap 27" in ground. Stamped:

Marked:

14" Ponderosa Pine N47 1/4 W--206.7' Scribed 1/4 S35 BT.
14" Ponderosa Pine S83 1/2 W--41.3' Scribed 1/4 S2 BT.
Set reference monument a 5/8"x30" iron rod with a 2" alum. cap N19W--23.4' Stamped: RM 1/4 S35, 1995, LS 896. S19E--23.4'.
Set a reference monument a 5/8"x30" iron rod with a 2" alum. cap S55 1/4 E--19.2' Stamped: RM 1/4 S2, 1995, LS 896, N55 1/4 W--19.2'.
Nailed 54-9 and 54-3 signs to BT's, painted bands and blazes red and nailed a 1" brass disk stamped PLS 896 flush between the B and T.
Set guard post North with 54-9 sign.

Bearings are true by instrument tie.

T11S R37E
1/4 S35 S2
T12S
1995
LS 896



Office of..... County of.....
State of....., I hereby certify that the within instrument was filed in this office
for record on the..... day of....., 19.....
..... by
(COUNTY OFFICIAL) (DEPUTY)