


CERTIFIED RECORD OF LAND CORNER MONUMENTATION

Z-25

History of original corner establishment:

Corner was established by Deputy Henry Meldrum in 1875, contract #226. Set: Basalt stone 36"x12"x10"

Corner was monumented by BLM in 1972 from original evidence. See record field notes.

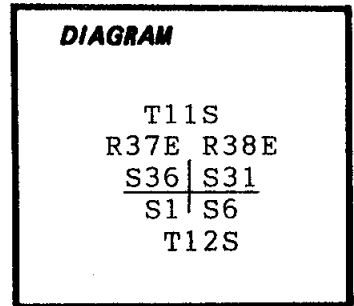

Description of corner evidence found:

BLM iron post with a 3" brass cap firmly set, buried in mound of stone of fence jack. Orig. stone along side.
Stamped:


T11S
R37E R38E
S36|S31
S1|S6
T12S
1972

BLM 15" now 28" Ponderosa Pine N69W--267.3' Healed blaze.

Description of monument and accessories | established to perpetuate the original location of this corner:

Set reference monuments 5/8"x30" iron rods with 2" alum. caps:
(1) N37W--14.8' Stamped RM T11S R37E S36 S37E--14.8' LS 896 1995.
(2) S51W--11.8' Stamped RM T12S R37E S1 N51E--11.8' LS 896 1995.
(3) N68E--11.7' Stamped RM T11S R38E S31 S68W--11.7' LS 896 1995.
Chiseled BXO on flush exposed bedrock 50"x20" S74E--24.4'.
Painted band, blaze and BXO red. Nailed 54-9 sign to nearby fence post.

Bearings are true by instrument tie.

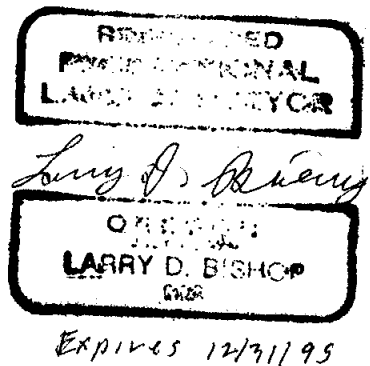

Office of..... County of.....
State of....., I hereby certify that the within instrument was filed in this office
for record on the..... day of....., 19.....
..... by
(COUNTY OFFICIAL) (DEPUTY)

Form R6-7100-57 (9/71)

FILED FEB. 4, 1998

*GPO-591-971, 1988

BAKER COUNTY SURVEYOR

SURVEY NO. 11-37-146

12-37-73

11-38-101

12-38-2