

CERTIFIED RECORD OF LAND CORNER MONUMENTATION

History of original corner establishment:

Eugene P. McCornack, U.S. Deputy Surveyor
July 27, 1881

40.00 Set a post 3 ft. long, 3 ins. square, 24 ins. in the ground for $\frac{1}{4}$ sec. cor., marked with $\frac{1}{4}$ S on W. face. From which:

A pine, 40 ins. diam., bears S.30°E., 50 lks. dist. mkd. $\frac{1}{4}$ SBT.
A pine, 24 ins. diam., bears N.60°W., 54 lks. dist. mkd. $\frac{1}{4}$ SBT.

DIAGRAM
T 11 S
R 37 E R 38 E
 $\frac{1}{4}$
S 12 | S 7
RLS 1060
1996

Description of corner evidence found:

No original evidence of the corner or the bearing trees found.

Description of monument and accessories I established to perpetuate the original location of this corner:


At proportionate position, set a 3 $\frac{1}{4}$ " diam. U.S.F.S. aluminum capped pipe, 30" long, with a magnet, 20" in the ground, with a mound of stone and earth to cap, from which:

A pine, 9" in diam., bears N.37°E., 88.1 ft., double blazed and scribed " $\frac{1}{4}$ S7BT" with a brass washer "RLS 1060" nailed to the face of the blaze between the B and T.
A pine, 14" in diam., bears S.80°E., 32.3 ft., double blazed and scribed " $\frac{1}{4}$ S7BT" with a brass washer "RLS 1060" nailed to the face of the blaze between the B and T.
A pine, 26" in diam., bears S.9°W., 101.9 ft., double blazed and scribed " $\frac{1}{4}$ S12BT" with a brass washer "RLS 1060" nailed to the face of the blaze between the B and T.
A pine, 15" in diam., bears N.46 $\frac{1}{4}$ °W., 30.2 ft., double blazed and scribed " $\frac{1}{4}$ S12BT" with a brass washer "RLS 1060" nailed to the face of the blaze between the B and T.


Placed Forest Service signs (54-2,54-9) on trees and paint scars, blazes and a 6" red band around BT's.
Placed two steel fence posts three to five feet from corner near property line with Forest Service signs (54-2).

Office of _____ County of _____
State of _____ I hereby certify that the within instrument was filed in this office
for record on the ____ day of _____, 19____
_____ by _____
(COUNTY OFFICIAL) (DEPUTY)

G-1

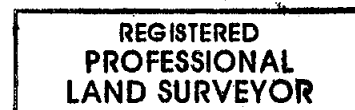

R. David Schurian 2/98

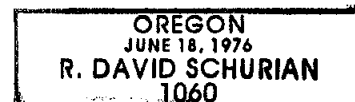

FILED May 29 1998
BAKER COUNTY SURVEYOR
SURVEY NO. 11-37-150/11-38-132