

LEGAL DESCRIPTION

The U.S. Forest Service administered lands include: the North half, the Southeast one-quarter, and the Northeast one-quarter of the Southwest one-quarter of Section 10; and the South half, the West half of the Northwest one-quarter, the East half of the Northeast one-quarter and the Northwest one-quarter of the Northeast one-quarter of Section 11; and the North half of the Northwest one-quarter, the North half of the Northeast one-quarter, the Southeast one-quarter of the Northeast one-quarter and the East half of the Southeast one-quarter of Section 14; and the Northeast one-quarter of the Northeast one-quarter, the Northwest one-quarter, the North half of the Southwest one-quarter, and the Southwest one-quarter of the Southwest one-quarter of Section 15, Township 11 South, Range 35 East, W.M.

NARRATIVE

The purpose of this survey is to monument property corners and to post the property lines between private lands and U.S. Forest Service lands.

This township was subdivided under contract #416 by Herman D. Grodan in October 1881. All of his G.L.O. corners in these four sections were monumented with 2 1/2\" x 28\" iron pipes with brass caps from original evidence by the B.L.M. in 1971 and 1972 except the quarter corner between Sections 13 and 14. I searched for that corner before and after my control survey and could not find the original stone or remains of the 2 1/2\". There has been logging and fires in the area. I set that corner on a straight line between the section corners using the call of a creek which runs Southwest 0.10 chain South of the corner. The corner falls in a boggy spring area.

Under contract #004345N for the U.S.F.S., James Hambleton resurveyed two adjacent sections (Sec. 12 & Sec. 23) in 1974. My length of the line between Sections 14 and 23 is substantially different from Hambleton's. I set a monument for the East one-sixteenth common to Sec. 14 and 23, approximately 37 feet East of Hambleton's monument for the same corner. When contacted on 10/23/83, he said he would remove his monument.

Steel fence posts with U.S.F.S. Property Boundary signs were set on the posted lines. Instruments used were Jena O.A. Theodolite and MAC I. E.M.D. Bearings are true based on a solar observation.



SURVEYOR CERTIFICATE

I, G. Dennis Edwards, a registered land surveyor in the State of Oregon, hereby certify that this plat and the notes hereon, or attached, are a correct representation of a survey I performed for the U.S. Forest Service in accordance with the statutes of the State of Oregon and the articles of my contract.

G. Dennis Edwards (a) G. Dennis Edwards
Registered Land Surveyor
Oregon License 951

LEGEND

- denotes 2 1/2\" iron pipe with Brass Cap found
- denotes 2 1/2\" x 30\" iron pipe with Brass Cap set
- denotes posted line
- () denotes G.L.O. record bearings and distances
- [] denotes James Hambleton's bearings and distances

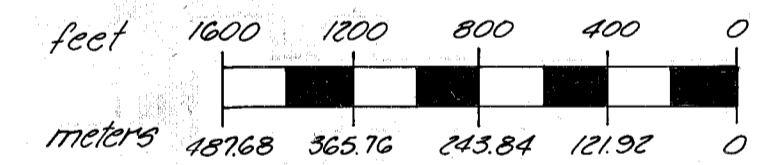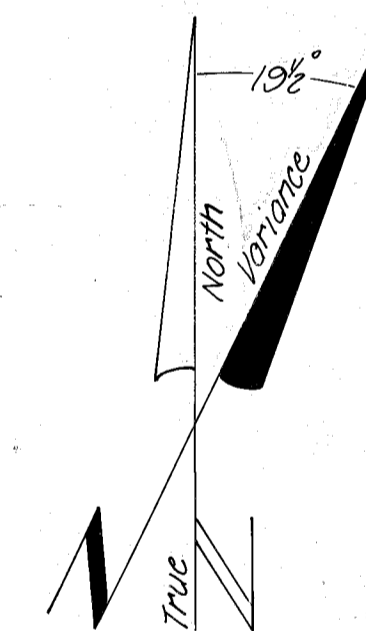

Scale: 1\" = 600'

FILED Dec. 6, 1983
BAKER COUNTY SURVEYOR
SURVEY NO. 11-38-57

EDWARDS SURVEYING 20.5th St. Hermiston, Oregon 97838 567-3536		Scale 1\" = 600'	Drn. By MLD	Drng. No.	Revision 1
Survey for U.S. FOREST SERVICE Contract No. 53-04M3-3-2909 Secs 10, 11, 14 & 15, T11S, R35E, W.M. Baker County, Oregon		Date 11-18-83	Ckd. By G.D.E.	Job No.	Revision 2
REGISTERED PROFESSIONAL LAND SURVEYOR G. Dennis Edwards OREGON JULY 16, 1971 DENNIS EDWARDS 551					