
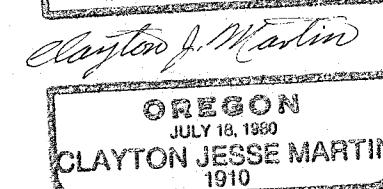


rd of Survey for Wallowa-Whitman National Forest  
ble Co-op Survey, Contract No. 04M3-9-6055  
29, T.11 S., R.38 E., W.M., Baker County, Oregon

Cor, Sec's. 29,30,31,32, G.L.O., set, a granite stone, 20"x12"x5", 15" in the ground, mkd. with 1 notch on the South 5 notches on the East edges, from which bear; 1. a 14" diam. Juniper, N.60°E., 23 links, mkd. T11SR38ES29BT, 2. a diam. Juniper, S.80°E., 23 links, mkd. T11SR38ES32BT, 3. a 20" diam. Juniper, S.10°W., 56 links, mkd. T11SR38ES31BT, M., found the corner monumented with the original basalt stone (record, granite), 20"x12"x4", firmly set 8" in the ground in a mound of stones, 3' base, 1½' high, mkd. with 1 groove on S. face and 5 grooves on E. face, from which the originaling trees; 1. a juniper, 30" diam., bears N. 60° E., 23 lks., with scribes T11SR38ES29BT visible on partially open blaze. juniper, 30" diam., bears S. 80° E., 23 lks., with scribes T11SR38ES32BT visible on partially open blaze. 3. a juniper, diam., bears S. 7° W., 46 lks., with scribes T11SR38ES31BT visible on partially open blaze. (Record, S. 10° W., 56 lks.) he corner point set, an iron post, 28" long, 2½" diam., 12" in the ground to bedrock, supported by a collar of stone, ase, to top, with brass cap mkd. per sketch, from which corner new bearing trees, 1. a juniper, 8" diam., bears S. 78° W. lks., mkd. T11SR38ES31BT. 2. a fir, 11" diam., bears N. 40° W., 140 lks., mkd. T11SR38ES30BT. Bury the cornerstone gside the iron post. I found a 3½" B.L.M. brass cap on a 2½" iron pipe, in a stone mound. Cap mkd. per sketch. Steel on East side of monument. 1. 19" D.B.H. (30") Juniper, N.60°E., 23 lks., with scribes visible on an open face. 2. 20" H. (30") Juniper, S.88°E., (S.80°E.) 23 lks., with scribes visible on an open face. 3. 28" D.B.H. (30") Juniper, S.2°W., ks., (S.7°W. B.L.M.) (S.10°W., 56 lks. G.L.O.) with full scribes visible. 4. 10" D.B.H.(8") Juniper, S.78°W., 102 lks., bes visible on partly healed face. 5. 17" D.B.H.(11") Douglas Fir, N.40°W., 140 lks., healed blaze. All the trees are thy and have B.T. tags.

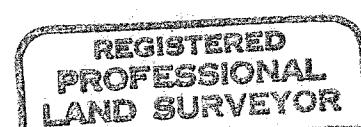

C.J. MARTIN SURVEYING  
2751 JUNIPER ST.  
SWEET HOME, OR 97386

FILED April 2, 1990

BAKER COUNTY SURVEYOR

SURVEY NO. 11-38-90