
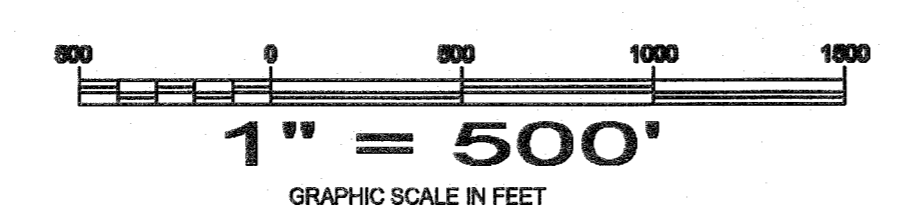
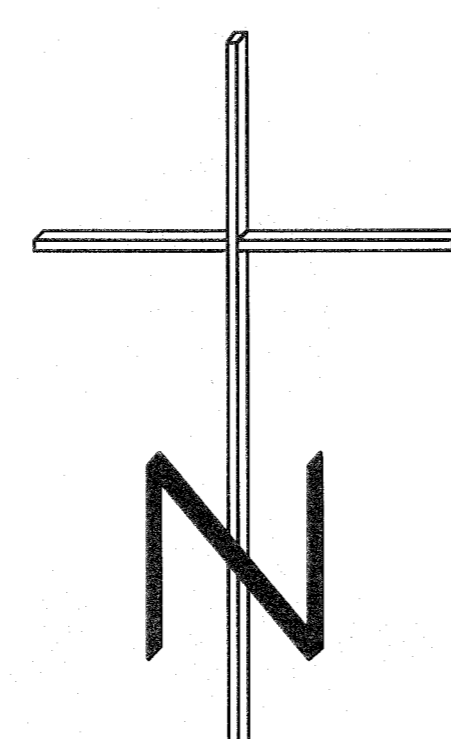
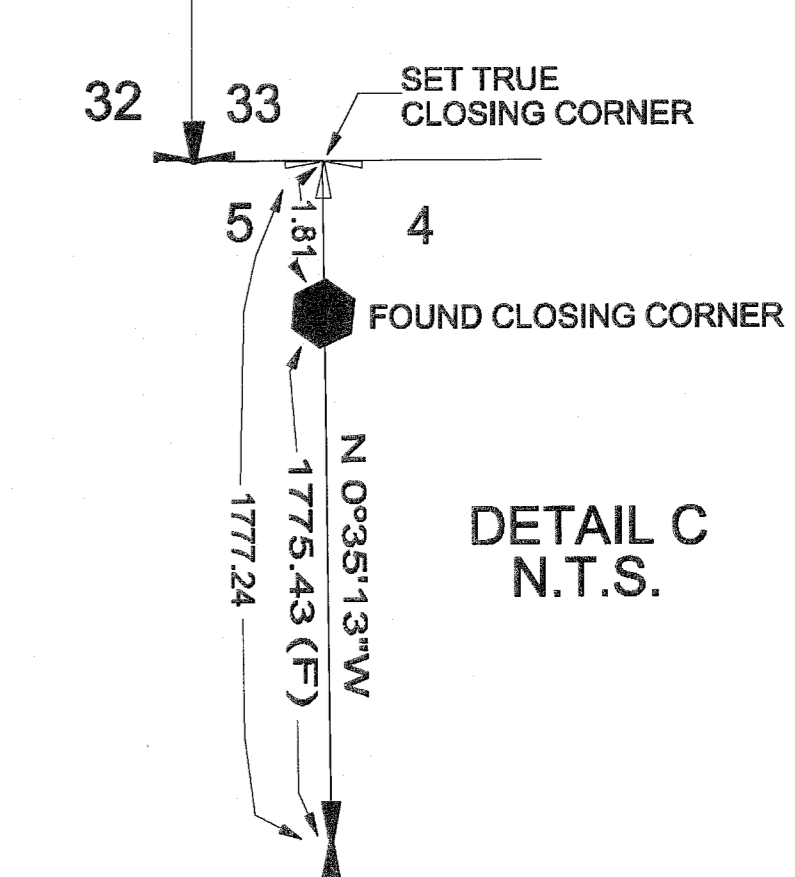
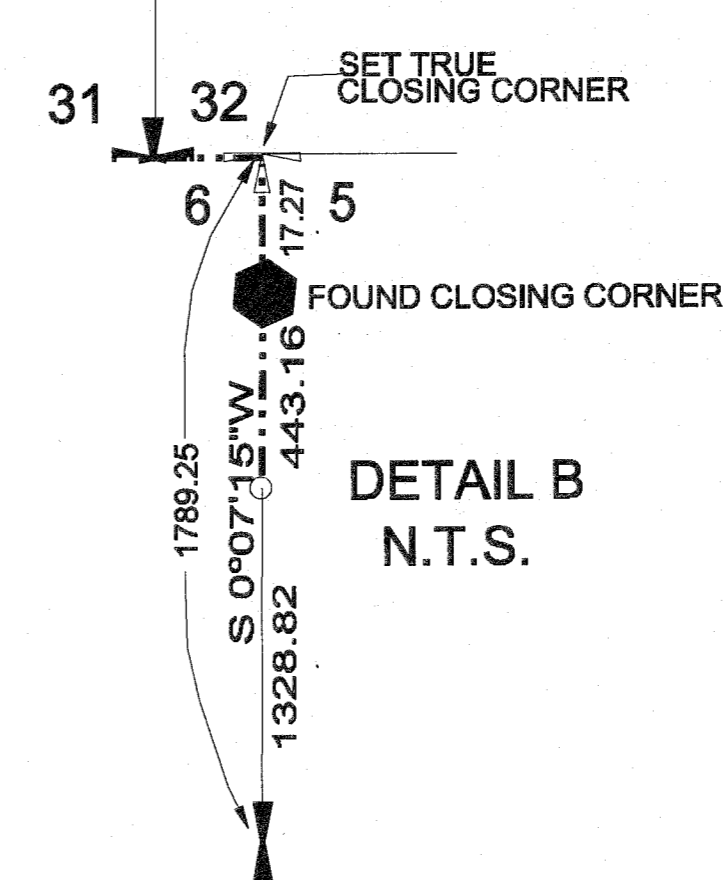
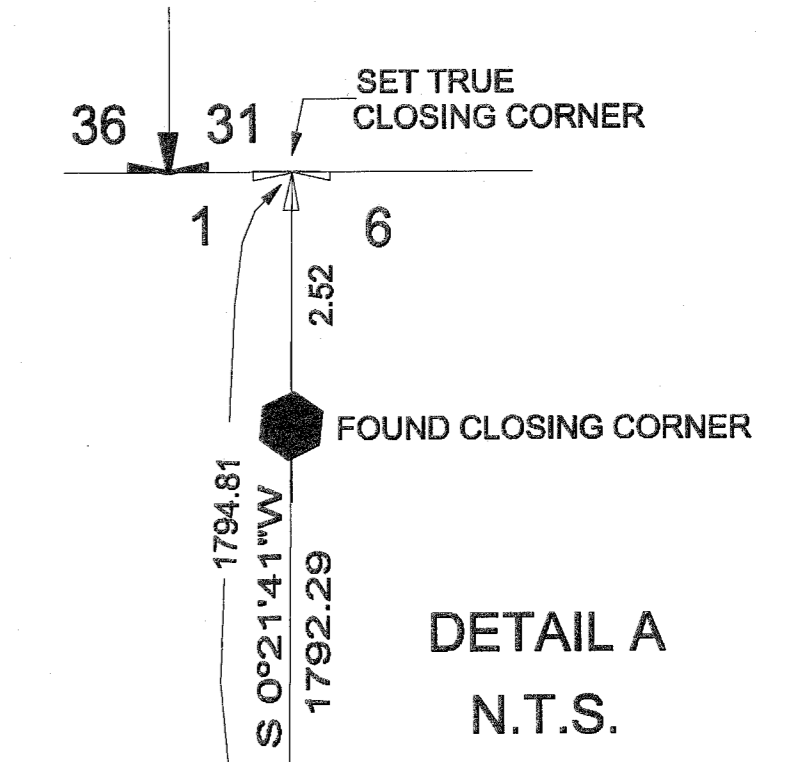


# RUSTY BULL CADASTRAL SURVEY

## WALLOWA-WHITMAN NATIONAL FOREST

SEE BAKER COUNTY SURVEY NUMBER \_\_\_\_\_

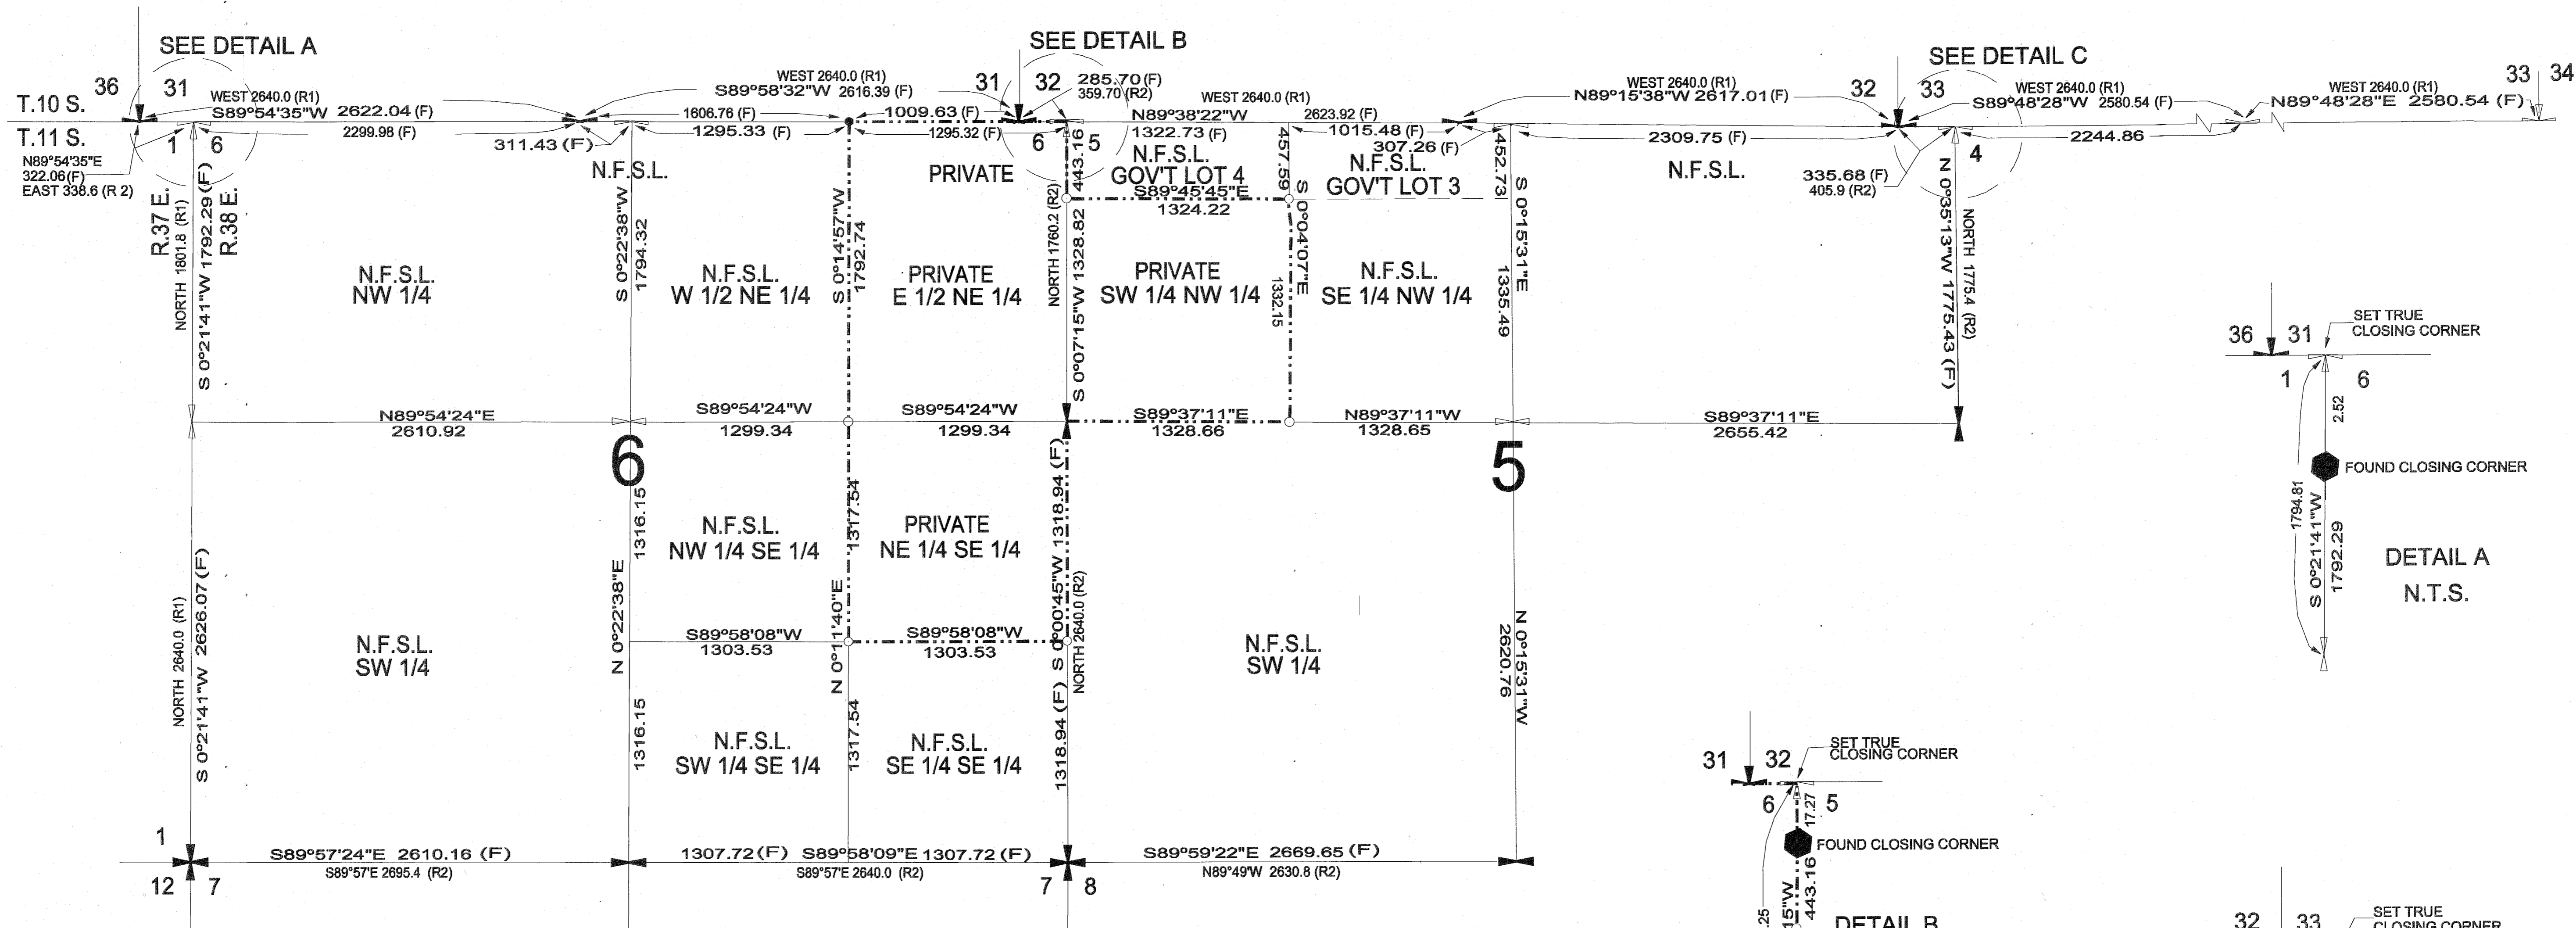

SHEET 2 OF 2

**RECORD OF SURVEY**

SECTIONS 5, 6 & 7, T.11 S., R.38 E.,  
WILLAMETTE MERIDIAN,  
BAKER COUNTY, OREGON

FILED May 26, 1998  
BAKER COUNTY SURVEYOR  
SURVEY NO. 11-38-104

**Western OUTBACK** INCORPORATED  
LAND & MINERAL SURVEYORS  
1440 W. RANCHO FELIZ PL., TUCSON AZ, 85737-2954  
PHONE & FAX (602) 544-4333