

LEGEND

- Set 2-1/2" x 30" aluminum pipe with 3-1/2" aluminum cap stamped as shown in the "MONUMENTATION" section.
- ⊙ Found acceptable evidence, set monument as described above
- Found monument of record, as described in the "History" and the notes at each corner.
- () Record bearing and distance as reported by Henry Meldrum in 1875 under GLO Contract No. 226
- () Record bearing and distance as reported by Henry W. Cooke in 1881 under GLO Contract No. 418
- [] Record bearing and distance as reported by William L. Hanley, PLS 1639 and William R. Wells, PLS 1106, in 1986; Baker County Map of Survey No's 11-39-20 and 11-39-21.
- Exterior Section Lines
- - - Center section lines
- - - Subdivisional lines
- N.F.S.L. NATIONAL FOREST SYSTEM LANDS
- PVT. PRIVATE LAND
- PVT. N.F.S.L. Marked forest boundary with steel posts and forest boundary signs at maximum intervals of 300 ft.
- Existing fence line with long line showing direction
- /// Existing road

Found Bureau of Land Management brass cap monument and accessories as set in 1970 from original evidence.



Found Bureau of Land Management brass cap monument and accessories as set in 1972 from original evidence.

Re-monumented by William L. Hanley, P.L.S. 1639, from Original Evidence in 1986

DOOLEY T.11S. R.39E. SHEET 2 OF 4

Re-established from Original Evidence and Bureau of Land Management Evidence by Edwin A. Stryker, P.L.S. 2060 in 1991.

Magnetic Declination 20° East

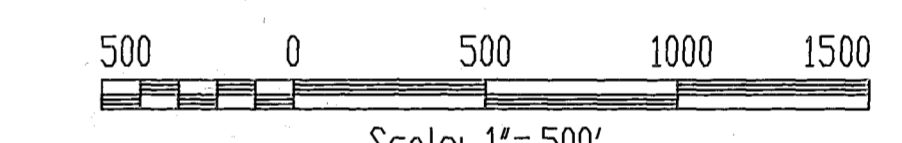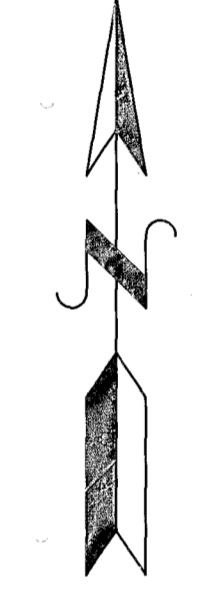

Basis of Bearing: Solar Observations

REGISTERED PROFESSIONAL LAND SURVEYOR
OREGON
JULY 12, 1988
DOUGLAS M. FERGUSON
848

S29 S28 NOT SURVEYED
S32 S33 THIS SURVEY

NOT SURVEYED THIS SURVEY

Found Bureau of Land Management brass cap monument and accessories as set in 1972 from original evidence.

Found Bureau of Land Management brass cap monument and accessories as set in 1972 from original evidence.

Found Bureau of Land Management brass cap monument and accessories as set in 1972 from original evidence.

Found stone with faint marks. Varified it's position with tie to section corner west.

Found Bureau of Land Management brass cap monument and accessories as set in 1972 from original evidence.

Made extensive search of this area, found no evidence.

Corner lost to logging.

Corner falls in road prism, lost to road construction.

Search area heavily mined. Corner apparently lost to mining activity.

Found Bureau of Land Management brass cap monument and accessories as set in 1972 from original evidence.

MATCH LINE
SHEET 1
SHEET 2

FILED May 26 1992
BAKER COUNTY SURVEYOR
SURVEY NO. 1139-110