# DOOLEY
# T.11S. R.39E.
# SHEET 3 OF 4

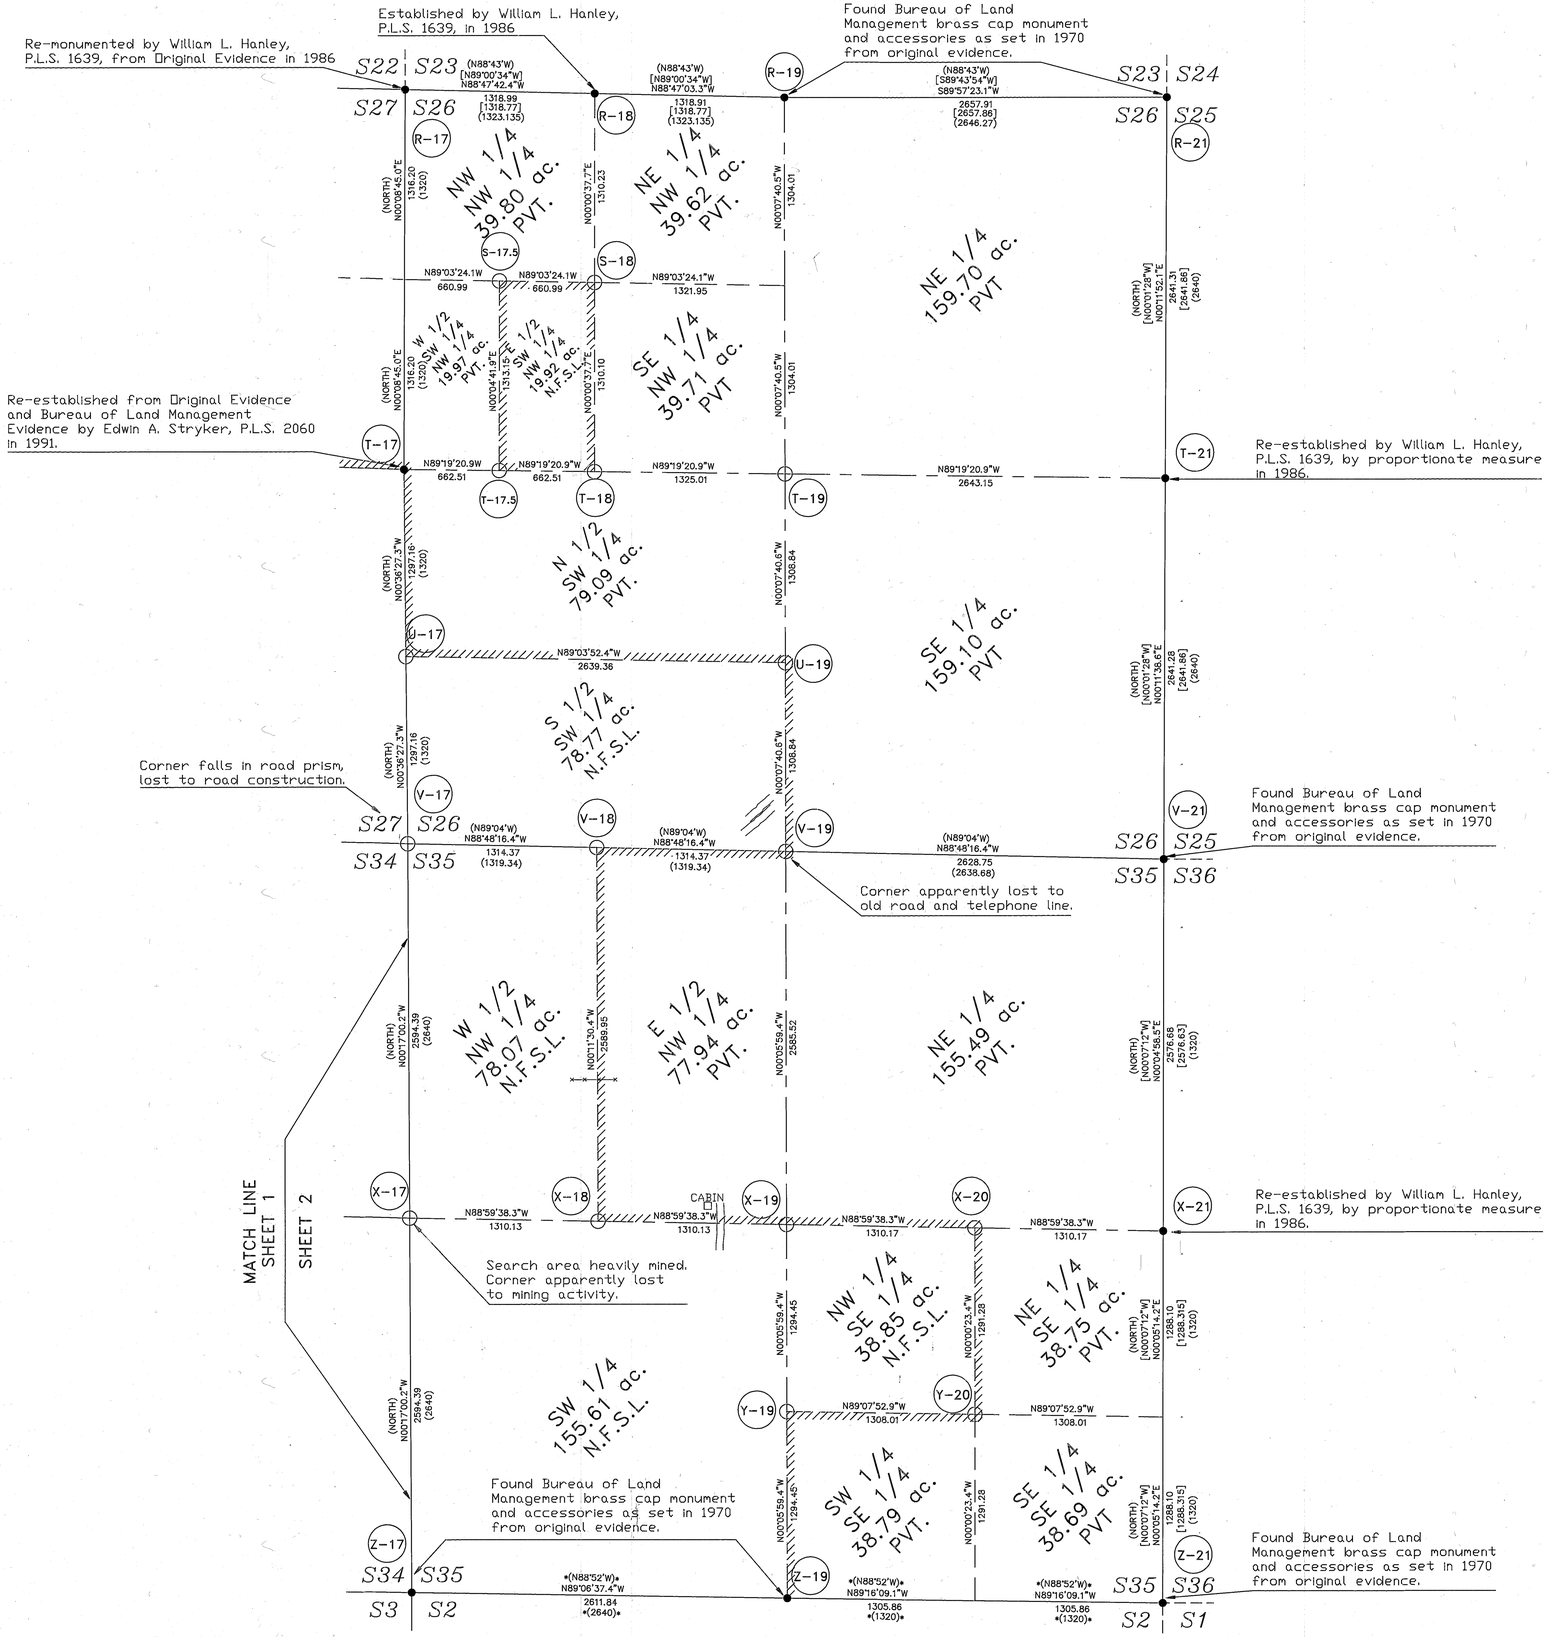


*Magnetic Declination 20° East*

500 0 500 1000 1500

Scale: 1"= 500'

*Basis of bearing: Solar Observations*

## LEGEND

| | |
|---|---|
| ○ | Set 2-1/2" x 30" aluminum pipe with 3-1/2" aluminum cap stamped as shown in the "MONUMENTATION" section. |
| ◎ | Found acceptable evidence, set monument as described above |
| ● | Found monument of record, as described in the "History" and the notes at each corner. |
| *( )* | Record bearing and distance as reported by Henry Meldrum in 1875 under GLO Contract No. 226 |
| ( ) | Record bearing and distance as reported by Henry W. Cooke in 1881 under GLO Contract No. 418 |
| [ ] | Record bearing and distance as reported by William L. Hanley, PLS 1639 and William R. Wells, PLS 1106, in 1986; Baker County Map of Survey No's 11-39-20 and 11-39-21. |
| ——— | Exterior Section Lines |
| ——— – ——— | Center section lines |
| — — — — — | Subdivisional lines |
| N.F.S.L. | NATIONAL FOREST SYSTEM LANDS |
| PVT. | PRIVATE LAND |
| PVT. N.F.S.L. | Marked forest boundary with steel posts and forest boundary signs at maximum intervals of 300 ft. |
| ×—×—× | Existing fence line with long line showing direction |
| // | Existing road |

REGISTERED PROFESSIONAL LAND SURVEYOR
OREGON JULY 12, 1968
DOUGLAS M. FERGUSON 848

FILED May 26, 1992
BAKER COUNTY SURVEYOR
SURVEY NO. 11-39-110