


CORNER RESTORATION

CORNER: N1/4 SEC. 2 TWP. 11 S. RANGE 39 E.

ORIGINAL SURVEY BY: Corner

CONTRACT NUMBER: Not Previously



CONTRACT DATE: Established

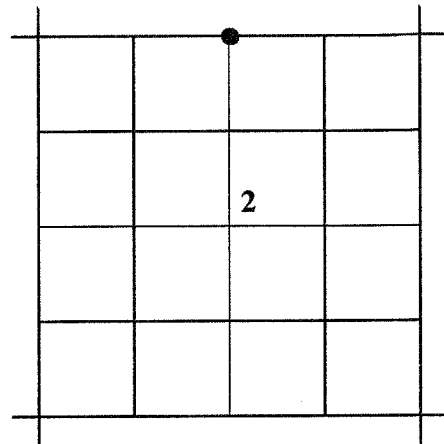

ORIGINAL DESCRIPTION: None

RESTORATION BY, STAMP AND DATE:

J.L. Hatfield
M.C. Springer

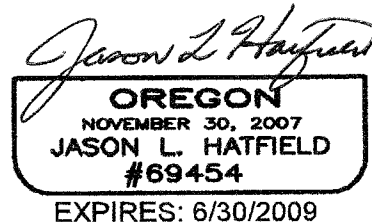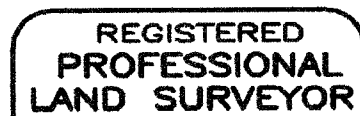

June 17, 2008

EVIDENCE FOUND: None

See Record Survey No. 11-39-157

DESCRIPTION OF MONUMENTS AND ACCESSORIES SET AND METHODS USED:

Show how trees are scribed and basis of bearings including compass var.

At the corner point: I set a 1½"x30" galv. iron pipe, 6" in the ground, with attached Bagett, Griffith and Blackman brass cap marked as shown.

From which I SCRIBE NEW BEARING TREES:


A 20" diameter ponderosa pine bears S18°50'E, 81.00 ft., marked T11S R39E 1/4 S2 BT.

A 14" diameter juniper bears S33°30'W, 47.85 ft. marked T11S R39E 1/4 S2 BT.

I also SET NEW REFERENCE POINTS:

A 5/8"x30" iron pin, bears N56°00'05"W, 25.39 ft., with attached alum. cap marked BGB SURVEY MARKER RP 1 2008.

A 5/8"x30" iron pin, bears N19°30'55"E, 30.63 ft., with attached alum. cap marked BGB SURVEY MARKER RP 2 2008.

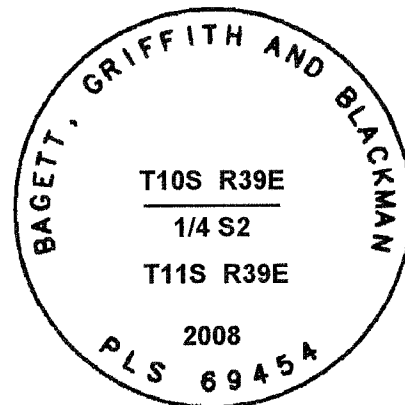

Raised a mound of stone 4 ft. base to top of cap. Used RTK GPS to measure accessories. Distances to BT's were measured with a steel tape to a 50d nail driven in the side-center at the root crown of the trees. Attached BT tags to the trees.

FILED July 21, 2008
BAKER COUNTY SURVEYOR
SURVEY NO. 11-39-159