


CORNER RESTORATION

CORNER: W1/4 SEC. 2 TWP. 11 S. RANGE 39 E.

ORIGINAL SURVEY BY: Henry W. Cooke

CONTRACT NUMBER: 418

CONTRACT DATE: August 30, 1881

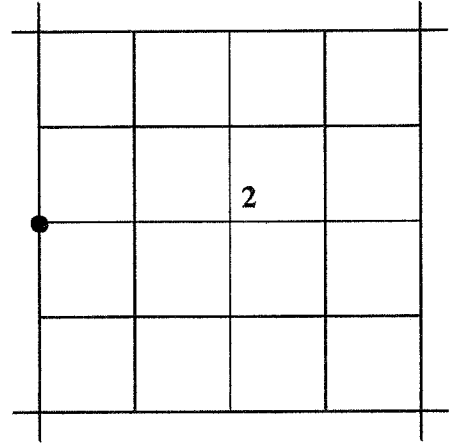

ORIGINAL DESCRIPTION: Set a basalt stone 14X8X7 9 in. deep marked 1/4 on West face for 1/4 sec. cor. raised Md. stone alongside.

RESTORATION BY, STAMP AND DATE:

J.L. Hatfield
M.C. Springer



June 24, 2008

EVIDENCE FOUND: After a diligent search, I found no remaining evidence of this corner, possibly due to road construction in the immediate vicinity. I declare this corner lost, and establish its position at single proportionate measure between the established northwest corner of Section 2, and the found B.L.M. monument at the southwest corner of Section 2. This corner falls in a north-south fence.

See Record Survey No. 11-39-157

DESCRIPTION OF MONUMENTS AND ACCESSORIES SET AND METHODS USED:

Show how trees are scribed and basis of bearings including compass var. At the corner point: I set a 1½"x30" galv. iron pipe, 24" in the ground, with attached Bagett, Griffith and Blackman brass cap marked as shown.

From which I SCRIBE NEW BEARING TREES:


A 10" diameter juniper bears N84°50'W, 19.2 ft., marked T11S R39E 1/4 S3 BT.

The westerly trunk of a double-trunk juniper, 13" diameter, bears S24°58'E, 103.1 ft., marked T11S R39E 1/4 S2 BT.

I also SET NEW REFERENCE POINTS:

A 5/8"x30" iron pin, bears N45°53'04"E, 33.13 ft., with attached alum. cap marked BGB SURVEY MARKER RP 1 2008.

A 5/8"x30" iron pin, bears S44°16'23"W, 44.38 ft., with attached alum. cap marked BGB SURVEY MARKER RP 2 2008.

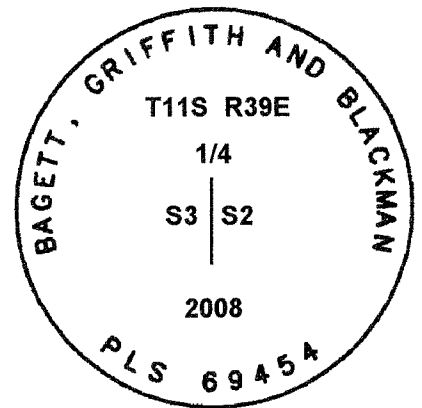

Raised a mound of stone 3 ft. base to top of cap. Used RTK GPS to measure accessories. Distances to BT's measured with a steel tape to a 50d nail driven in the side-center at the root crown of the trees. Attached a BT tags to the trees.

FILED July 21, 2008
BAKER COUNTY SURVEYOR
SURVEY NO. 11-39-1163