


CORNER RESTORATION

CORNER: SE SEC. 2 TWP. 11 S. RANGE 39 E.

ORIGINAL SURVEY BY: Henry W. Cooke

CONTRACT NUMBER: 418

CONTRACT DATE: August 30, 1881

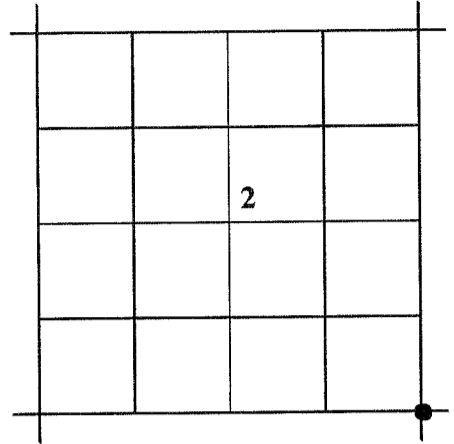

ORIGINAL DESCRIPTION: Set a basalt stone 16X12X12 10 in. deep for cor. to Sec. 1,2, 11, 12 marked with 5 notches to S. 1 notch on E. edges raised Md stone alongside.

RESTORATION BY, STAMP AND DATE:

J.L. Hatfield
M.C. Springer



June 24, 2008

EVIDENCE FOUND: The corner of Sections 1, 2, 11 and 12 is determined at the corner of barbed wire fences which extend north, east and south, being the best available evidence of the corner position.

See Record Survey No. 11-39-157

DESCRIPTION OF MONUMENTS AND ACCESSORIES SET AND METHODS USED:

Show how trees are scribed and basis of bearings including compass var. At the corner point: I set a 1½"x30" galv. iron pipe, 20" in the ground, with attached Bagett, Griffith and Blackman brass cap marked as shown.


From which I SET NEW REFERENCE POINTS:

A 5/8"x30" iron pin, bears S00°23'53"E, 21.50 ft., with attached alum. cap marked BGB SURVEY MARKER RP 1 2008.

A 5/8"x30" iron pin, bears N88°01'40"W, 25.82 ft., with attached alum. cap marked BGB SURVEY MARKER RP 2 2008.

A 5/8"x30" iron pin, bears N03°34'06"E, 20.36 ft., with attached alum. cap marked BGB SURVEY MARKER RP 3 2008.

A 5/8"x30" iron pin, bears S88°19'17"E, 20.92 ft., with attached alum. cap marked BGB SURVEY MARKER RP 4 2008.

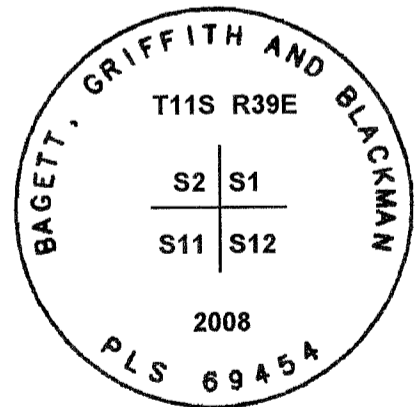

Raised a mound of stone 3 ft. base to top of cap. Used RTK GPS to measure accessories.

FILED July 21, 2008
BAKER COUNTY SURVEYOR
SURVEY NO. 11-39-169