

CERTIFIED RECORD OF LAND CORNER MONUMENTATION

History of original corner establishment:


Corner monumented by William L. Hanley, LS 1639, recorded in 1986 as Baker Co. Survey No. 11-39-64.

Record states:

Set 2 1/2" x 30" aluminum pipe with 2 1/2" aluminum cap, stamped as shown on the diagram, 25" in the ground, and surrounded with a mound of earth and stone.

From which:

- A fir, 9 ins. diam., bears N. 65° E., 15.8 ft. dist., marked: C1/4 S14 BT.
- A fir, 9 ins. diam., bears N. 42° W., 31.2 ft. dist., marked: C1/4 S14 BT.
- A pine, 7 ins. diam., bears N. 85° W., 67.0 ft. dist., marked: C1/4 S14 BT.
- A pine, 5 ins. diam., bears N. 31° W., 90.2 ft. dist., marked: X BT.

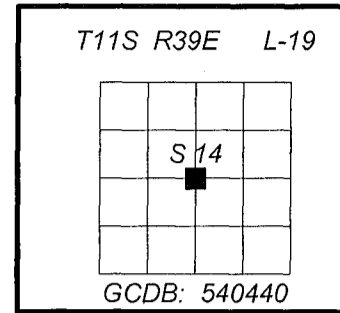

Description of corner evidence found:

Found a 2 1/2" x 30" aluminum pipe with 2 1/2" aluminum cap, stamped as shown on the diagram, 6" above ground, with 3 ft. diam. stone mound to top.

From which I find Hanley bearing trees:

- A fir cut stump, bears N. 65° E., 15.8 ft. dist., with no visible marks.
- A fir snag, bears N. 42° W., 31.2 ft. dist., with visible scribe on open blaze.
- A pine, 9 ins. diam., alive and healthy, bears N. 85° W., 67.0 ft. dist., with visible scribe on open blaze.
- A fir cut stump, bears, N. 31° W., 90.2 ft. dist., with no visible marks.

Description of monument and accessories I established to perpetuate original location of this corner:

Established new bearing trees:

- A ponderosa pine, 18 ins. diam., bears S. 8 1/2° E., 92.0 ft. dist., scribed C1/4 S14 BT.
- A fir, 12 ins. diam., bears N. 27 3/4° W., 28.8 ft. dist., scribed X BT.

Also set bearing object:

- A pink magnet bears, S. 52° E., 11.5 ft. dist., buried 1 ft. deep in earth.

NAD 83 (CORS '96) geographic position:


Lat. 44°36'28.2" N
Long. 117°54'05.2" W

All bearing trees are painted with red bands, and have Bearing Tree (54-3) and Land Survey Monument (54-9) signs attached. All new bearing trees have a metal washer stamped "LS 2648" nailed to the side-center.

Posted National Forest Boundary East and West from corner with Property Boundary (54-2) signs, and a Land Survey Monument (54-9) sign on nearby post.

I hereby certify that the corner was monumented and accessories taken as described, using a staff compass, set with 15 1/2° East declination, and steel tape on 8/27/2008.

Witnesses: Matthew Brockamp, Dustin Palmer and Shane Silver.

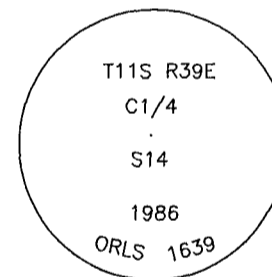

REGISTERED
PROFESSIONAL
LAND SURVEYOR

[Signature]
OREGON
JANUARY 18, 1994
RON C. WALTER
2648

Renewal Date: June 30, 2010

Office of _____ County Surveyor _____ County of _____ Baker _____
State of _____ Oregon _____, I hereby certify that the within instrument was filed in this office
for record on the _____ day of _____, 20 _____
_____ by _____
(COUNTY OFFICIAL) _____ (DEPUTY)

FILED December 9, 2008