

CERTIFIED RECORD OF LAND CORNER MONUMENTATION

History of original corner establishment:

Corner established by Henry W. Cooke under Contract No. 418 dated August 30, 1881.

Surveyor General Records state:

Set a pine post 3ft. long, 3 ins. square for 1/4 sec. cor. marked 1/4 S on W. face.
 From which
 A pine, 30 ins. diam., bears N. 48° E., 44 lks. dist., marked 1/4 S BT.
 A pine, 40 ins. diam., bears S. 53° W., 127 lks. dist., marked 1/4 S BT.

Subsequent Monumentation:

Corner position remonumented by BLM cadastral surveyor Peter A. Peterson under special instructions dated May 3, 1957, and approved March 28, 1977.

Record states:

The 1/4 sec. cor. of secs. 13 and 14, determined at record bearing and distance from the remains of the original bearing trees:


A pine, 29 ins. diam., bears N. 48° E., 44 lks. dist., with scribe marks 1/4 S visible on partially open double blaze.
 A root hole, bears S. 53° W., 127 lks. dist., with with a down and decayed pine alongside, no marks visible.

At the corner point

Set an iron post 28 ins. long, 2 1/2 ins. diam., 24 ins. in the ground, with brass cap mkd. as shown on the diagram.

From which a new bearing tree:

A ponderosa pine, 10 ins. diam., bears S. 79° W., 59 lks. dist., mkd. 1/4 S14 BT.
 Set a steel fence post and deposit the corner stone alongside the iron post

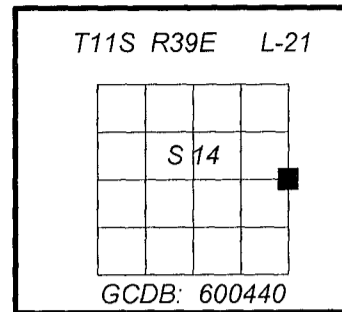

Description of corner evidence found:

Found a 2 1/2" x 28" galvanized iron pipe with standard BLM 3 1/4" brass cap, stamped as shown on the diagram, firmly set, 8" above ground, with 3 ft. diam. stone mound to top.

From which GLO bearing trees:

A pine snag, 29 ins. diam., bears N. 48° E., 44 lks. dist., visible scribe on open double blaze.
 A stump hole, bears S. 53° W., 127 lks. dist., with decayed pine alongside, no marks visible.

Also Petersen bearing tree:

A pine, 21 ins. diam., alive and healthy, bears S. 79° W., 59 lks. dist., with healed blaze.

Description of monument and accessories I established to perpetuate original location of this corner:

Established new bearing trees

A ponderosa pine, 12 ins. diam., bears N. 25° E., 7.7 ft. dist., scribed 1/4 S13 BT.
 A ponderosa pine, 9 ins. diam., bears S. 68 1/2° E., 26.7 ft. dist., scribed 1/4 S13 BT.
 A ponderosa pine, 12 ins. diam., bears N. 22 1/2° W., 29.8 ft. dist., scribed 1/4 S14 BT.

NAD 83 (CORS '96) geographic position:


Lat. 44°36'28.2" N
 Long. 117°53'28.9" W

All bearing trees are painted with red bands, and have Bearing Tree (54-3) and Land Survey Monument (54-9) signs attached. All new bearing trees have a metal washer stamped "LS 2648" nailed to the side-center.

Posted National Forest Boundary South and West from corner with Property Boundary (54-2) signs, and a Land Survey Monument (54-9) sign on nearby post.

I hereby certify that the corner was monumented and accessories taken as described, using a staff compass, set with 15 1/2° East declination, and steel tape on 8/ 26/ 2008.

Witnesses: Matthew Brockamp and Dustin Palmer.

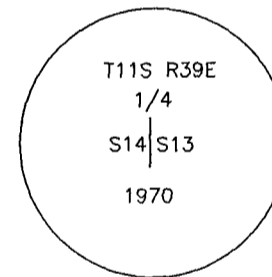

REGISTERED
PROFESSIONAL
LAND SURVEYOR

Ron C. Walter
OREGON
JANUARY 18, 1994
RON C. WALTER
2648

Renewal Date: June 30, 2010

Office of County Surveyor County of Baker
 State of Oregon , I hereby certify that the within instrument was filed in this office
 for record on the day of , 20

..... by
 (COUNTY OFFICIAL) (DEPUTY)

FILED December 9, 2008