


**CERTIFIED RECORD OF LAND CORNER MONUMENTATION**

**History of original corner establishment:**

Corner established by Henry W. Cooke under Contract No. 418 dated August 30, 1881.  
 Record states:  
 Set a basalt stone 18x16x14, 12 ins. deep for cor. to sec. 14,15,22,23, mkd. with 3 notches on S. and 2 notches on E. edge.  
 From which:  
 A pine 40 ins. diam., bears N. 72° E., 64 lks. dist., mkd., T11S R39E S 14 BT.  
 A pine 24 ins. diam., bears S. 30° E., 15 lks. dist., mkd., T11S R39E S 23 BT.  
 A pine 26 ins. diam., bears S. 80° W., 104 lks. dist., mkd., T11S R39E S 22 BT.  
 A pine 18 ins. diam., bears N. 57° W., 155 lks. dist., mkd., T11S R39E S 15 BT.

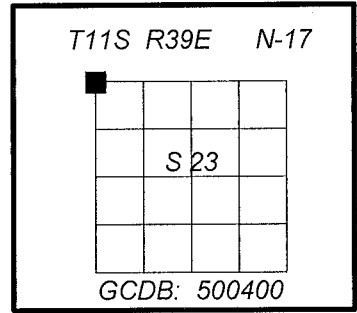

**Subsequent Monumentation:**

Corner position remonumented by BLM cadastral surveyor Peter A. Peterson under special instructions dated May 3, 1957, and approved March 28, 1977.

Record states:  
 The corner position determined at record bearing and distance from the remains of the original bearing trees:  
 A pine, 40 ins. diam., bears N. 72° E., 64 lks. dist., with scribe marks T11S 39 S14 visible on open blaze.  
 A pine snag, 24 ins. diam., bears S. 30° E., 15 lks. dist., with scribe marks T11S R39E S23 BT visible on open blaze.  
 At the corner point, set an iron post 28 ins. long, 2 1/2 ins. diam., 24 ins. in the ground, with brass cap mkd. as shown on the diagram.  
 From which new bearing trees:  
 A ponderosa pine, 12 ins. diam., bears S. 47 1/2° E., 22 lks. dist., mkd T11S R39E S23 BT.  
 A ponderosa pine, 11 ins. diam., bears S. 26° W., 49 lks. dist., mkd T11S R39E S22 BT.  
 A ponderosa pine, 10 ins. diam., bears N. 65° W., 40 lks. dist., mkd T11S R39E S15 BT.  
 Set a steel fence post alongside the iron post.

**Description of corner evidence found:**


Found a standard BLM 2 1/2" iron pipe with 3 3/4" brass cap, stamped as shown on the diagram, 3" above the ground with rock collar.

Recovered GLO bearing trees:  
 A ponderosa pine, 40 ins. diam., alive and healthy, bears N. 72° E., 64 lks. dist., with visible scribe on open blaze.  
 A pine snag, 24 ins. diam., bears S. 30° E., 15 lks. dist., with visible scribe on open blaze.

Recovered Peterson bearing trees:  
 A ponderosa pine snag, 16 ins. diam., bears S. 47 1/2° E., 22 lks. dist., with healed blaze.  
 A ponderosa pine, 13 ins. diam., alive and healthy, bears S. 26° W., 49 lks. dist., with visible scribe on open blaze.  
 A ponderosa pine snag, 14 ins. diam., bears N. 65° W., 40 lks. dist., with visible scribe on open blaze.

**Description of monument and accessories I established to perpetuate original location of this corner:**

Established new bearing trees:  
 A ponderosa pine, 13 ins. diam., bears S. 49° E., 45.4 ft. dist., scribed T11S R39E S23 BT.  
 A Douglas fir, 14 ins. diam., bears N. 78° W., 70.5 ft. dist., scribed T11S R39E S15 BT.

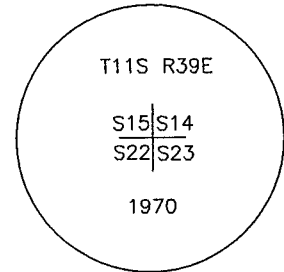

NAD 83 (CORS '96) geographic position:  
 Lat. 44°36'02.5" N  
 Long. 117°54'41.6" W  
 All bearing trees are painted with red bands, and have Bearing Tree (54-3) and Land Survey Monument (54-9) signs attached. All new bearing trees have a metal washer stamped "LS 2648" nailed to the side-center.

Found steel fence post 5 ft. South from corner with Property Boundary (54-2) signs, and a Land Survey Monument (54-9) sign on post.

I hereby certify that the corner was monumented and accessories taken as described, using a staff compass, set with 15 1/2° East declination, and steel tape on 8/ 28/ 2008.

Witnesses: Matthew Brockamp, Dustin Palmer and Shane Silver.

REGISTERED  
PROFESSIONAL  
LAND SURVEYOR

*[Signature]*  
OREGON  
JANUARY 18, 1994  
RON C. WALTER  
2648

Renewal Date: June 30, 2010

Office of ..... County Surveyor ..... County of ..... Baker .....  
 State of ..... Oregon ..... , I hereby certify that the within instrument was filed in this office  
 for record on the ..... day of ..... , 20 .....  
 ..... by .....  
 (COUNTY OFFICIAL) ..... (DEPUTY)

FILED December 9, 2008  
 BAKER COUNTY SURVEYOR  
 SURVEY NO. 11-39-173