

CERTIFIED RECORD OF LAND CORNER MONUMENTATION

History of original corner establishment:


Corner monumented by William L. Hanley, LS 1639, recorded in 1986 as Baker Co. Survey No. 11-39-48.

Record states:

Set 2 1/2" x 30" aluminum pipe with 2 1/2" aluminum cap, stamped as shown on the diagram, 25" in the ground and surrounded with a mound of earth and stone.

From which:

- A pine, 15 ins. diam., bears N. 41° W., 70.8 ft. dist., marked: W 1/16 S14 BT.
- A pine, 7 ins. diam., bears S. 73° W., 12.6 ft. dist., marked: W 1/16 S23 BT.

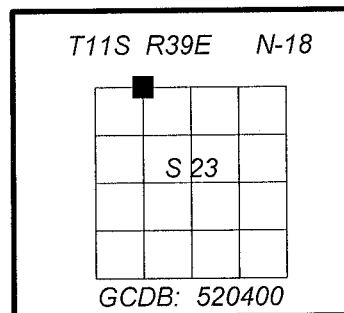

Description of corner evidence found:

Found a 2 1/2" x 30" aluminum pipe with 2 1/2" aluminum cap, stamped as shown on the diagram, firmly set, 4" above ground, with 3 ft. diam. stone mound to top.

From which I find Hanley bearing trees:

- A pine, 21 ins. diam., bears S. 73° W., 12.6 ft. dist., alive and healthy with healed blaze.
- A pine, dead and down, bears N. 41° W., 70.8 ft. dist..

Description of monument and accessories I established to perpetuate original location of this corner:

Established new bearing tree:

A ponderosa pine, 9 ins. diam., bears N. 74 1/2° W., 68.8 ft. dist., scribed W1/16 S14 BT.

NAD 83 (CORS '96) geographic position:


Lat. 44°36'02.8" N
Long. 117°54'23.2" W

All bearing trees are painted with red bands, and have Bearing Tree (54-3) and Land Survey Monument (54-9) signs attached. All new bearing trees have a metal washer stamped "LS 2648" nailed to the side-center.

Posted National Forest Boundary South and West from corner with Property Boundary (54-2) signs, and a Land Survey Monument (54-9) sign on nearby post.

I hereby certify that the corner was monumented and accessories taken as described, using a staff compass, set with 15 1/2° East declination, and steel tape on 9/03/2008.

Witnesses: Matthew Brockamp and Shane Silver.

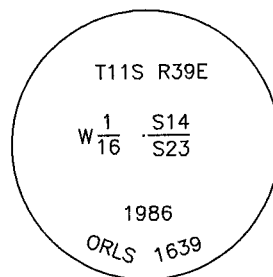

REGISTERED
PROFESSIONAL
LAND SURVEYOR

[Signature]
OREGON
JANUARY 18, 1994
RON C. WALTER
2648

Renewal Date: June 30, 2010

Office of County Surveyor County of Baker
State of Oregon , I hereby certify that the within instrument was filed in this office
for record on the day of , 20
..... by
(COUNTY OFFICIAL) (DEPUTY)

FILED December 9, 2008