


CERTIFIED RECORD OF LAND CORNER MONUMENTATION

History of original corner establishment:

Corner established by Henry W. Cooke under Contract No. 418 dated August 30, 1881.
 Surveyor General Records state:
 Set basalt stone 16x16x16, 10 ins. deep for cor. to sec. 13,14, 23, 24, marked 3 notches on S. and 1 notch on E. edge.
 From which
 A pine, 20 ins. diam., bears N. 15° E., 9 lks. dist., marked T11S R39E S13 BT.
 A pine, 20 ins. diam., bears N. 81° W., 28 lks. dist., marked T11S R39E S14 BT.
 A pine, 18 ins. diam., bears S. 77° W., 51 lks. dist., marked T11S R39E S23 BT.
 A pine, 22 ins. diam., bears S. 87° E., 54 lks. dist., marked T11S R39E S24 BT.

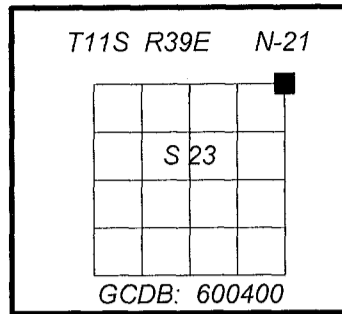

Subsequent Monumentation:


Corner position remonumented by BLM cadastral surveyor Peter A. Peterson under special instructions dated May 3, 1957, and approved March 28, 1977.
 Record states:
 The cor. of secs. 13, 14, 23, and 24, monumented with the original basalt stone, 16x14x12 ins., firmly set 8 ins. in the ground, mkd. with 3 grooves on S. face and 1 groove on E. face.
 from which the remains of the original bearing trees:
 A pine, 18 ins. diam., bears N. 15° E., 9 lks. dist., with scribe marks T11S R39E S13 BT visible on open double blaze.
 A decayed pine stump, 20 ins. diam., bears S. 83° E., 54 lks. dist., with scribe marks BT visible on open blaze. (Record, S. 87° E.)
 A pine, 24 ins. diam., bears S. 77° W., 51 lks. dist., with healed double blaze.
 A pine, 21 ins. diam., bears N. 81° W., 28 lks. dist., with illegible scribe marks visible on open double blaze.
 At the corner point
 Set an iron post 28 ins. long, 2 1/2 ins. diam., 22 ins. in the ground, in a mound of stone, 2 ft. base, to top, with brass cap mkd. as shown on the diagram.
 From which a new bearing tree:
 A ponderosa pine, 10 ins. diam., bears S. 72 1/4° E., 93 lks. dist., mkd T11S R39E S24 BT.
 Set a steel fence post and deposit the corner stone alongside the iron post

Description of corner evidence found:

Found a 2 1/2" x 28" galvanized iron pipe with standard BLM 3 1/4" brass cap, stamped as shown on the diagram, firmly set, 4" above ground, with rock collar.
 From which GLO bearing trees:
 A pine snag, 19 ins. diam., bears N. 15° E., 9 lks. dist., visible scribe on open double blaze.
 A decayed pine stump, bears S. 83° E., 54 lks. dist.
 A pine, 25 ins. diam., alive and healthy, bears S. 77° W., 51 lks. dist., with healed double blaze.
 A pine, 23 ins. diam., alive and healthy, bears N. 81° W., 28 lks. dist., with healed blaze.
 Also Petersen bearing tree:
 A pine, 13 ins. diam., alive and healthy, bears S. 72 1/4° E., 93 lks. dist., with visible scribe on open blaze.

Description of monument and accessories I established to perpetuate original location of this corner:

Established new bearing tree
 A ponderosa pine, 17 ins. diam., bears N. 29 1/2° E., 38.5 ft. dist., scribed T11S R39E S13 BT.
 NAD 83 (CORS '96) geographic position:
 Lat. 44°36'01.7" N
 Long. 117°53'28.6" W

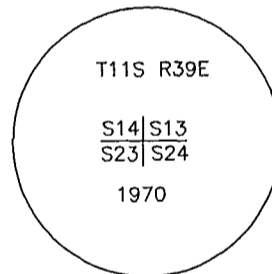

All bearing trees are painted with red bands, and have Bearing Tree (54-3) and Land Survey Monument (54-9) signs attached. All new bearing trees have a metal washer stamped "LS 2648" nailed to the side-center.

Posted National Forest Boundary North and West from corner with Property Boundary (54-2) signs, and a Land Survey Monument (54-9) sign on nearby post.

I hereby certify that the corner was monumented and accessories taken as described, using a staff compass, set with 15 1/2° East declination, and steel tape on 8/26/2008.

Witnesses: Matthew Brockamp and Dustin Palmer.

REGISTERED
PROFESSIONAL
LAND SURVEYOR

Ron C. Walter
OREGON
JANUARY 18, 1994
RON C. WALTER
2648

Renewal Date: June 30, 2010

Office of County Surveyor County of Baker
 State of Oregon , I hereby certify that the within instrument was filed in this office
 for record on the day of , 20
 by
 (COUNTY OFFICIAL) (DEPUTY)

FILED December 9, 2008
 BAKER COUNTY SURVEYOR
 SURVEY NO. 11-39-175