

CERTIFIED RECORD OF LAND CORNER MONUMENTATION

History of original corner establishment:

Corner monumented by Douglas M. Ferguson, LS 848, recorded in 1992 as Baker Co. Survey No. 11-39-120.


Record states:

Set 2 1/2" x 30" aluminum pipe with 3 1/2" aluminum cap, stamped as shown on the diagram, 8" in the ground and raised a 2' high by 3' dia. mound of stone around the monument.

From which:

A white fir, 10 ins. diam., bears N. 09° 21' E., 31.1 ft. dist., marked: CE 1/16 S27 BT.

A white fir, 8 ins. diam., bears S. 68° 22' W., 24.7 ft. dist., marked: CE 1/16 S27 BT.

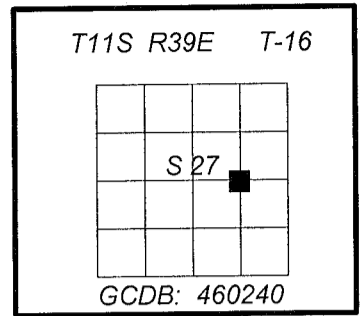

Description of corner evidence found:

Found a 2 1/2" x 30" aluminum pipe with 3 1/2" aluminum cap, lying horizontal in remains of stone mound, on steep slope.

Recovered bearing trees:

A white fir, 10 ins. diam., alive and healthy, bears N. 09° 21' E., 31.1 ft. dist., with healed blaze.

A white fir, 10 ins. diam., alive and healthy, bears S. 68° 22' W., 24.7 ft. dist., with healed blaze.

Description of monument and accessories I established to perpetuate original location of this corner:

The found monument was reset at the record position from the recovered bearing trees.

Set 2 1/2" x 30" aluminum pipe with 3 1/2" aluminum cap, stamped as shown on the diagram, 14" in the ground and raised a 5' dia. mound of stone around the monument, to top.

NAD 83 (CORS '96) geographic position:


Lat. 44°34'45.2" N
Long. 117°55'00.0" W

All bearing trees are painted with red bands, and have Bearing Tree (54-3) and Land Survey Monument (54-9) signs attached. All new bearing trees have a metal washer stamped "LS 2648" nailed to the side-center.

Posted National Forest Boundary East and North from corner with Property Boundary (54-2) signs, and a Land Survey Monument (54-9) sign on nearby post.

I hereby certify that the corner was monumented and accessories taken as described, using a staff compass, set with 15 1/2° East declination, and steel tape on 9/ 02/ 2008.

Witnesses: Matthew Brockamp, Dustin Palmer and Shane Silver.

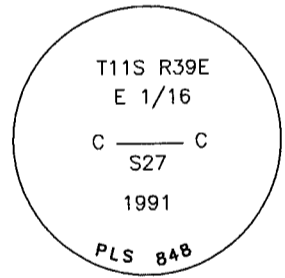

REGISTERED
PROFESSIONAL
LAND SURVEYOR

[Signature]
OREGON
JANUARY 18, 1994
RON C. WALTER
2648

Renewal Date: June 30, 2010

Office of _____ County Surveyor _____ County of _____ Baker _____
State of _____ Oregon _____, I hereby certify that the within instrument was filed in this office
for record on the _____ day of _____, 20 _____
_____ by _____
(COUNTY OFFICIAL) _____ (DEPUTY)

FILED December 9, 2008