

CERTIFIED RECORD OF LAND CORNER MONUMENTATION

History of original corner establishment:

Corner monumented by Douglas M. Ferguson, LS 848, recorded in 1992 as Baker Co. Survey No. 11-39-124.


Record states:

Set 2 1/2" x 30" aluminum pipe with 3 1/2" aluminum cap, stamped as shown on the diagram, 26" in the ground.

From which:

A white fir, 14 ins. diam., bears N. 40° 34' E., 9.8 ft. dist., marked: S1/16 S26 BT.

A Western Larch, 8 ins. diam., bears N. 59° 40' W., 63.9 ft. dist., marked: S1/16 S27 BT.

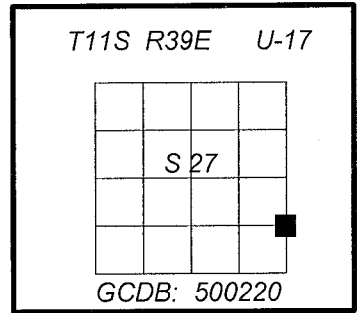


Description of corner evidence found:

Found a 2 1/2" x 30" aluminum pipe with 3 1/2" aluminum cap, mis-marked as shown on the diagram, 5" above the ground with embedded rock collar.

Recovered bearing trees:

A white fir, 15 ins. diam., alive and healthy, bears N. 40° 34' E., 9.8 ft. dist., with healed blaze.

A Western Larch, 9 ins. diam., bears N. 59° 40' W., 63.9 ft. dist., dead and down.

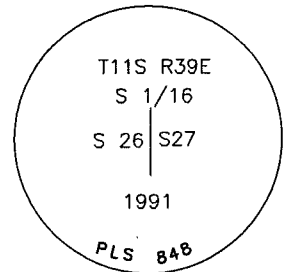

Description of monument and accessories I established to perpetuate original location of this corner:

Established new Bearing Tree:

An 11" Western Larch bears N. 59° W., 87.7 ft., scribed: S 1/16 S27 BT.

NAD 83 (CORS '96) geographic position:

Lat. 44°34'32.6" N
Long. 117°54'41.3" W

All bearing trees are painted with red bands, and have Bearing Tree (54-3) and Land Survey Monument (54-9) signs attached. All new bearing trees have a metal washer stamped "LS 2648" nailed to the side-center.

Posted National Forest Boundary East and North from corner with Property Boundary (54-2) signs, and a Land Survey Monument (54-9) sign on nearby post.

I hereby certify that the corner was monumented and accessories taken as described, using a staff compass, set with 15 1/2° East declination, and steel tape on 9/02/2008.

Witnesses: Matthew Brockamp, Dustin Palmer and Shane Silver.

REGISTERED
PROFESSIONAL
LAND SURVEYOR

OREGON
JANUARY 18, 1994
RON C. WALTER
2648

Renewal Date: June 30, 2010

Office of County Surveyor County of Baker
State of Oregon I hereby certify that the within instrument was filed in this office
for record on the day of , 20
..... by
(COUNTY OFFICIAL) (DEPUTY)

FILED December 9, 2008