

CERTIFIED RECORD OF LAND CORNER MONUMENTATION

History of original corner establishment:

Corner monumented by Douglas M. Ferguson, LS 848, recorded in 1992 as Baker Co. Survey No. 11-39-141.


Record states:

Set 2 1/2" x 30" aluminum pipe with 3 1/2" aluminum cap, stamped as shown on the diagram, 18" in the ground and raised a mound of stone around the monument.

From which:

A juniper, 8 ins. diam., bears S. 45° 51' E., 38.8 ft. dist., marked: CW 1/16 S35 BT.

A juniper, 12 ins. diam., bears S. 17° 48' W., 33.1 ft. dist., marked: CW 1/16 S35 BT.

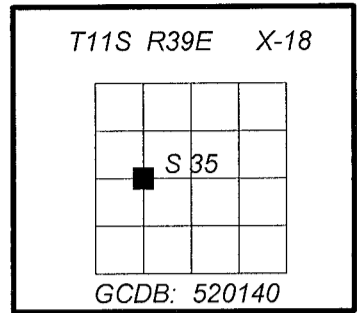

Description of corner evidence found:

Found a 2 1/2" x 30" aluminum pipe with 3 1/2" aluminum cap, stamped as shown on the diagram, firmly set, 7" above ground, with 3 ft. diam. stone mound to top.

From which:

A juniper, 9 ins. diam., bears S. 45° 51' E., 38.8 ft. dist., alive and healthy with visible scribe on open blaze.

A juniper, 14 ins. diam., bears S. 17° 48' W., 32.1 ft. dist., alive and healthy with visible scribe on open blaze. (Record 33.1 ft. dist.)

Description of monument and accessories I established to perpetuate original location of this corner:


NAD 83 (CORS '96) geographic position:
Lat. 44°33'53.7" N
Long. 117°54'22.4" W

All bearing trees are painted with red bands, and have Bearing Tree (54-3) and Land Survey Monument (54-9) signs attached. All new bearing trees have a metal washer stamped "LS 2648" nailed to the side-center.

Posted National Forest Boundary East and North from corner with Property Boundary (54-2) signs, and a Land Survey Monument (54-9) sign on nearby post.

I hereby certify that the corner was monumented and accessories taken as described, using a staff compass, set with 15 1/2° East declination, and steel tape on 9/ 03/ 2008.

Witnesses: Matthew Brockamp and Shane Silver.

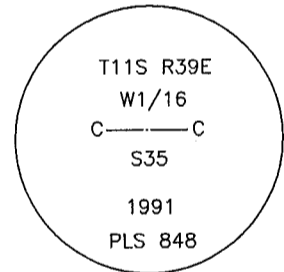

REGISTERED
PROFESSIONAL
LAND SURVEYOR

[Signature]
OREGON
JANUARY 18, 1994
RON C. WALTER
2648

Renewal Date: June 30, 2010

Office of County Surveyor County of Baker
State of Oregon , I hereby certify that the within instrument was filed in this office
for record on the day of , 20
..... by
(COUNTY OFFICIAL) (DEPUTY)

FILED December 9, 2008