


**CERTIFIED RECORD OF LAND CORNER MONUMENTATION**

**History of original corner establishment:**

Corner originally established by Henry Meldrum under Contract No. 226 in 1875.  
 Record states:  
 Set basalt stone 22x12x4 for 1/4 Sec. Cor.

**Subsequent Monumentation:**


In 1970, Corner recovered and remonumented by Peter A. Peterson under instructions dated May 03, 1957, and included in Group No. 350, approved March 28, 1977.  
 BLM record states:  
 The 1/4 sec. cor. of secs. 2 and 35, monumented with the original shale stone, 22x12x4 ins., firmly set 10 ins. in the ground, mkd. 1/4 on N. face. (Record, basalt). At the corner point set an iron post, 28 ins. long, 2 1/2 ins. diam., 24 ins. in the ground, in a mound of stone, 2 ft. base, to top, with brass cap mkd. as shown.  
 From which new bearing trees:  
 A ponderosa pine, 23 ins. diam., bears N. 30° E., 129 lks. dist., mkd. 1/4 S35 BT.  
 A ponderosa pine, 13 ins. diam., bears S. 47 3/4° W., 19 lks. dist., mkd. 1/4 S2 BT.  
 Set a steel fence post and deposit the corner stone alongside the iron post.

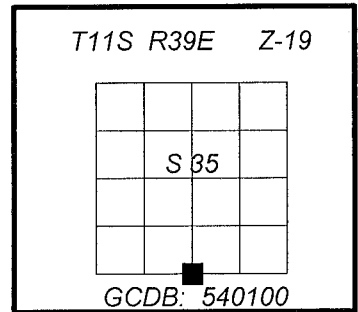

Corner maintained by Douglas M. Ferguson, LS 848, recorded in 1992 as Baker County Survey Record No. 11-39-152.  
 Record states:  
 Found 2 1/2" iron pipe with 3" brass cap stamped as shown, projecting 4" out of the ground, surrounded by a mound of stone. The monument is solid and in good condition.  
 Found BLM bearing trees:  
 A ponderosa pine, 32" dia., with healed blaze, bears N. 28°29' E., 84.1 ft., (1970 BLM Rec: N. 30° E., 85.14 ft.)  
 A ponderosa pine, 26" dia., with healed blaze, bears S. 48°12' W., 13.3 ft., (1970 BLM Rec: S. 47 3/4° W., 12.54 ft.)  
 Ferguson established new bearing trees:  
 A ponderosa pine, 9" dia., bears N. 38°30' W., 26.5 ft., scribed 1/4 S35 BT.  
 A ponderosa pine, 16" dia., bears S. 69°30' E., 54.1 ft., scribed 1/4 S2 BT.

**Description of corner evidence found:**

Found a standard BLM 2 1/2" x 30" galvanized iron pipe with 3 1/4" brass cap, stamped as shown on the diagram (not as shown on 11-39-152), 2" above the ground with rock collar.  
 Recovered Peterson bearing trees:  
 A ponderosa pine snag, 32 ins. diam., bears N. 28 1/2° E., 84.1 ft. dist., with healed blaze.  
 A ponderosa pine, 28 ins. diam., alive and healthy, bears S. 48 1/4° W., 13.3 ft. dist., with healed blaze.  
 Recovered Ferguson bearing trees:  
 A ponderosa pine, 16 ins. diam., alive and healthy, bears S. 69 1/2° E., 54.1 ft. dist., with healed blaze.  
 A ponderosa pine, 13 ins. diam., alive and healthy, bears N. 38 1/2° W., 26.5 ft. dist., with healed blaze.

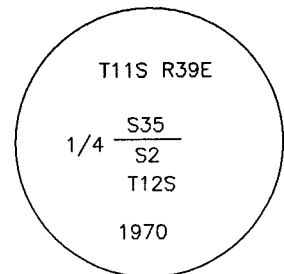

**Description of monument and accessories I established to perpetuate original location of this corner:**

Established new bearing tree:  
 A juniper, 7 ins. diam., bears N. 75° E., 34.2 ft. dist., scribed X BT.  
 NAD 83 (CORS '96) geographic position:  
 Lat. 44°33'28.2" N  
 Long. 117°54'03.9" W  
 All bearing trees are painted with red bands, and have Bearing Tree (54-3) and Land Survey Monument (54-9) signs attached. All new bearing trees have a metal washer stamped "LS 2648" nailed to the side-center.  
 Posted National Forest Boundary North from corner with Property Boundary (54-2) signs, and a Land Survey Monument (54-9) sign on nearby post.  
 I hereby certify that the corner was monumented and accessories taken as described, using a staff compass, set with 16° East declination, and steel tape on 9/ 03/ 2008.  
 Witnesses: Ron Walter and Dustin Palmer.

REGISTERED  
 PROFESSIONAL  
 LAND SURVEYOR

OREGON  
 JANUARY 18, 1994  
 RON C. WALTER  
 2648

Renewal Date: June 30, 2010

Office of ..... County Surveyor ..... County of ..... Baker .....  
 State of ..... Oregon ..... , I hereby certify that the within instrument was filed in this office  
 for record on the ..... day of ..... , 20 .....  
 ..... by .....

(COUNTY OFFICIAL) ..... (DEPUTY)

FILED December 9, 2008  
 BAKER COUNTY SURVEYOR  
 SURVEY NO. 11-39-180 / 12-39-39