

CERTIFIED RECORD OF LAND CORNER MONUMENTATION

F-9

History of original corner establishment:


Corner originally established in 1991 by Douglas M. Ferguson, PLS 848, under U.S. Forest Service contract. Ferguson's notes state:

Set 2 1/2"x30" aluminum pipe with 3 1/2" aluminum cap, stamped as shown on Diagram. Set 28" in the ground.

From Which:

A Pond. Pine, 16" in diam., bears N47°39'W, 34.8 ft., scribed: N1/16 S8 BT
A Pond. Pine, 12" in diam., bears S47°52'E, 8.5 ft., scribed: N1/16 S9 BT

Set steel fence post with Land Survey Monument (54-9) and Property Boundary (54-2) signs 7' north and 5' west of monument. Nailed brass washer stamped PLS 848 on blaze above BT scribe as taken this survey. Nailed Bearing Tree (54-3) signs above blaze and Land Survey Monument (54-9) signs on back of each tree as required. Painted a 6" red band above Bearing Tree signs and painted blaze red.

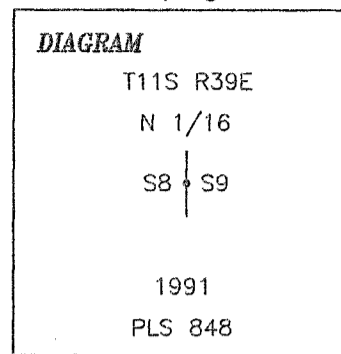

Description of corner evidence found:

A 3 1/2" aluminum cap on aluminum pipe marked as shown in corner diagram, 2" above ground.

From Which:

A stump hole with tree remnants bears N47°39'W, 34.8'
A Ponderosa Pine dead and down, bears S47°52'E, 8.5'

Steel fence post with 54-2 and 54-9 signs bears west, 3.8'. Steel fence post with 54-2 sign bears north, 7.1'.

Description of monument and accessories I established to perpetuate the original location of this corner:

Build small stone mound around monument and mark new bearing trees.

New Bearing Trees:

A Ponderosa Pine, 10" in diameter bears S44°W, 44.2' scribed N1/16 S8 BT.
A Ponderosa Pine, 14" in diameter bears S71°E, 59.6' scribed N1/16 S9 BT.

Distances to new bearing trees measured to 60d spike in right side center. Bearing trees have brass disks stamped PLS 2672 nailed between the B and T on lower face. Bearing trees have 54-3 and 54-9 signs, a 6" red painted band, and bearing tree faces painted red.

Geodetic Coordinates (NAD83):

N 44°37'36.3"
W 117°57'06.4"

Geodetic coordinates were obtained from a Garmin recreational grade GPS receiver and were averaged.

Date: May 23, 2013
Declination: 15°E

REGISTERED
PROFESSIONAL
LAND SURVEYOR

Kenneth A. Lind

OREGON
JULY 19, 1994
KENNETH A. LIND
2672

Renews: 12-31-14

FILED July 11, 2013

BAKER COUNTY SURVEYOR

SURVEY NO. 11-39-182

LCR_63B.dwg