


CERTIFIED RECORD OF LAND CORNER MONUMENTATION

HISTORY OF ORIGINAL CORNER ESTABLISHMENT:

Originally established by Douglas M. Ferguson in survey filed as Survey No. 11-39-72, office of the Baker County Surveyor. Monumentation record states:

Set 2 1/2"x30" aluminum pipe with 3 1/2" aluminum cap, from which:

- Pond. Pine, 16" in diam., bears N89°30'W, 50.1 ft., scribed: N1/16 S16 BT.
- Pond. Pine, 12" in diam., bears S83°30'E, 12.6 ft., scribed N1/16 S15 BT.

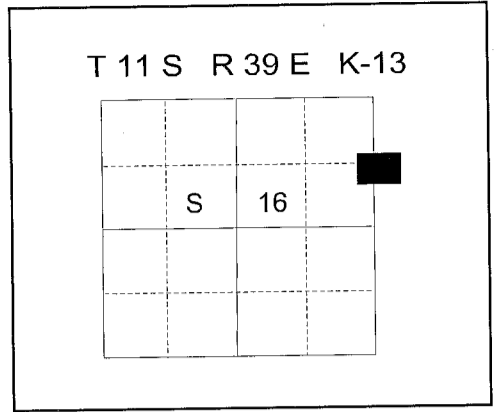

DESCRIPTION OF CORNER EVIDENCE FOUND:

Found 3 1/2" aluminum pipe with 2 1/2" aluminum cap marked as shown below, 2" above ground, from which:

- A 16 inch Ponderosa Pine bears South 82° East, a distance of 12.6 feet, alive and vigorous with a healed blaze.
- A 17 inch Ponderosa Pine snag, bears South 88° West, a distance of 50.1 feet, with scribe marks visible on a open blaze.

DESCRIPTION OF MONUMENT AND ACCESSORIES I ESTABLISHED

TO PERPETUATE THE ORIGINAL LOCATION OF THIS CORNER:

NEW BEARING OBJECTS:

- A 17 inch Ponderosa Pine bears North 65° West, a distance of 27.30 feet, marked N 1/16 S16 BT.


I hereby certify that the corner was perpetuated on November 19, 2013.

REGISTERED
PROFESSIONAL
LAND SURVEYOR



OREGON
June 2, 2010
JEFFREY S. HSU
83571

Renewal Date: June 30, 2015

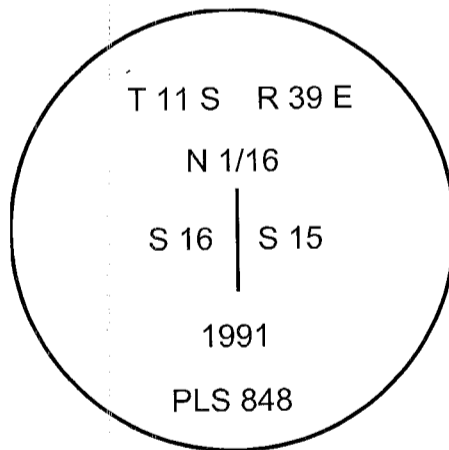

I used a steel tape and magnetic compass in the establishment of the accessories. Declination used was 16° East. Bearings and distances are taken to the center of the tree. On the new bearing tree, distance is taken to a 60d spike in the right hand side of the root crown.

K-13

FILED Dec. 10, 2013
BAKER COUNTY SURVEYOR
SURVEY NO. 11-39-185