


CERTIFIED RECORD OF LAND CORNER MONUMENTATION

HISTORY OF ORIGINAL CORNER ESTABLISHMENT:

Originally established by Douglas M. Ferguson in survey filed as Survey No. 11-39-72, office of the Baker County Surveyor. Monumentation record states:

Set 2 1/2"x30" aluminum pipe with 3 1/2" aluminum cap, from which:

- Pond. Pine, 14" in dia., bears N59°52'W, 10.6 ft., scribed: C1/4 S16 BT.
- Pond. Pine, 10" in dia., bears N36°48'E, 9.0 ft., scribed: C1/4 S16 BT.
- Pond. Pine, 14" in dia., bears S21°01'E, 17.6 ft., scribed C1/4 S16 BT.
- Pond. Pine 10" in dia., bears S70°49'W, 3.7 ft., scribed C1/4 S16 BT.

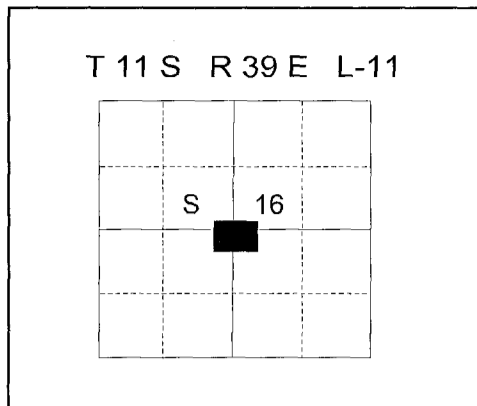

DESCRIPTION OF CORNER EVIDENCE FOUND:

Found 3 1/2" aluminum pipe with 2 1/2" aluminum cap marked as shown below, 4" above ground, from which:

- A 12 inch Ponderosa Pine bears North 36° East, a distance of 9.0 feet, alive and vigorous with healed blaze.
- A 15 inch Ponderosa Pine bears South 22° East, a distance of 17.6 feet, alive and vigorous with healed blaze.
- An 11 inch Ponderosa Pine bears South 72° West, a distance of 3.7 feet, alive and vigorous with healed blaze.
- A 15 inch pine stump bears North 60° West, a distance of 10.6 feet, with visible scribe marks.

DESCRIPTION OF MONUMENT AND ACCESSORIES I ESTABLISHED

TO PERPETUATE THE ORIGINAL LOCATION OF THIS CORNER:

NEW BEARING OBJECTS:


A 15 inch Ponderosa Pine bears North 35° West, a distance of 17.45 feet, marked C1/4 S16 BT.

I hereby certify that the corner was perpetuated on November 19, 2013.

REGISTERED
PROFESSIONAL
LAND SURVEYOR

OREGON
June 2, 2010
JEFFREY S. HSU
83571

Renewal Date: June 30, 2015

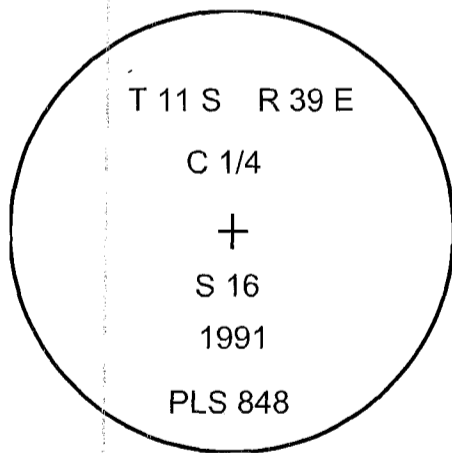

I used a steel tape and magnetic compass in the establishment of the accessories. Declination used was 16° East. Bearings and distances are taken to the center of the tree. On the new bearing tree, distance is taken to a 60d spike in the right hand side of the root crown.

L-11

FILED Dec. 10, 2013
BAKER COUNTY SURVEYOR
SURVEY NO. 11-39-186