

CERTIFIED RECORD OF LAND CORNER MONUMENTATION

HISTORY OF ORIGINAL CORNER ESTABLISHMENT:

Originally established by Henry W. Cooke under GLO Contract No. 418, dated August 30, 1881. Surveyor General record states:

Set a pine post 3 ft. long, 3 in. sqr with marked stone 12 in in ground for 1/4 sec cor. marked 1/4 S on W. face, from which:

Pine 10 in. dia. bears S25W, 20 lks. dist., marked 1/4 S BT.

Pine 24 in. dia. bears N50E, 27 lks. dist., marked 1/4 S BT.

Corner found and reestablished by William Wells in 1986. Baker County monumentation record states:

Set a 2 1/2" x 30" aluminum pipe with 2" aluminum cap 24" in the ground. New bearing trees:
A 13" ponderosa pine bears N85 1/2°E, 63.1' scribed 1/4 S15 BT.
An 8" ponderosa pine bears S23 1/2°W, 64.5' scribed 1/4 S16 BT.

Douglas Ferguson recovers Wells' corner in 1991. Baker County monumentation record states:

Found a 2 1/2" aluminum pipe with a 2 1/2" aluminum cap, extending 6 ins. out of the ground.
Pond. pine, 8" dia., partially healed blaze, bears S22°08'W, 64.3 ft.
Pond. Pine, 12" dia., partially healed blaze, bears N83°46'E, 63.0 ft.

Ferguson then takes additional accessories:

Pond. Pine, 10" in diam., bears N66°30'W, 13.1 ft., scribed: 1/4 S16 BT.
Pond. Pine, 12" in diam., bears N25°30'E, 17.2 ft., scribed: 1/4 S15 BT.


DESCRIPTION OF CORNER EVIDENCE FOUND:

Found 2 1/2" aluminum pipe with 2 1/2" aluminum cap marked as shown below, 6 inches above ground, from which:
A 16 inch Ponderosa Pine bears North 86° East, a distance of 63.0 feet, alive and vigorous with a healed blaze.
A 10 inch Ponderosa Pine bears South 24° West, a distance of 64.3 feet, alive and vigorous with scribe marks visible on partially healed blaze.
A 10 inch Ponderosa Pine bears North 65° West, a distance of 13.1 feet, alive and vigorous with scribe marks visible on a partially healed blaze.
Northeast tree taken by Ferguson dead and downed, original position could not be determined.

**DESCRIPTION OF MONUMENT AND ACCESSORIES I ESTABLISHED TO PERPETUATE THE ORIGINAL LOCATION OF THIS CORNER:
NEW BEARING OBJECTS:**

An 11 inch Ponderosa Pine bears South 58° East, a distance of 48.55 feet, marked 1/4 S15 BT.


I hereby certify that the corner was perpetuated on November 19, 2013.

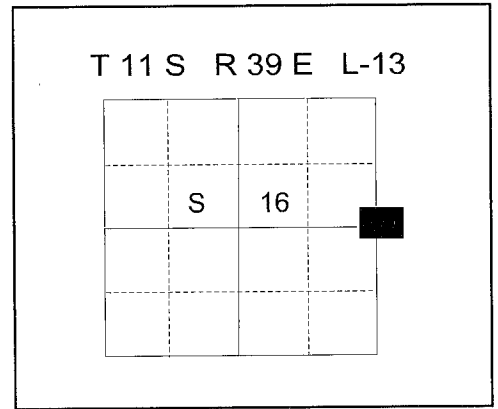

REGISTERED
PROFESSIONAL
LAND SURVEYOR

OREGON
June 2, 2010
JEFFREY S. HSU
83571

Renewal Date: June 30, 2015

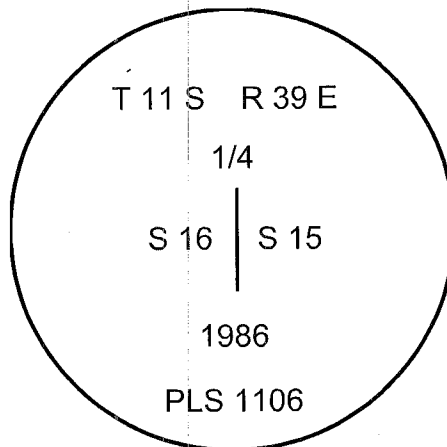

I used a steel tape and magnetic compass in the establishment of the accessories. Declination used was 16° East. Bearings and distances are taken to the center of the tree. On the new bearing tree, distance is taken to a 60d spike in the right hand side of the root crown.

FILED Dec. 10, 2013
BAKER COUNTY SURVEYOR
SURVEY NO. 11-39-188