


**CERTIFIED RECORD OF LAND CORNER MONUMENTATION**

**HISTORY OF ORIGINAL CORNER ESTABLISHMENT:**

Originally not previously established.

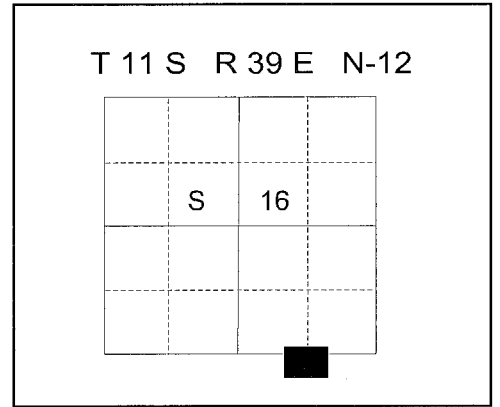

**DESCRIPTION OF CORNER EVIDENCE FOUND:**

None.

**DESCRIPTION OF MONUMENT AND ACCESSORIES I ESTABLISHED**

**TO PERPETUATE THE ORIGINAL LOCATION OF THIS CORNER:**

At position determined by survey, I set a 5/8"x30" iron pin with 2 1/2" aluminum cap, marked as shown below, 30 inches in the ground, from which:

A 19 inch Ponderosa Pine bears North 42° East, a distance of 78.65 feet, marked E 1/16 S16 BT.

A 10 inch Ponderosa Pine bears South 59° East, a distance of 25.45 feet, marked E 1/16 S21 BT.

I set a steel fencepost approximately 1 foot East of the monument.

I hereby certify that the corner was monumented on November 23, 2013.

REGISTERED  
PROFESSIONAL  
LAND SURVEYOR



OREGON  
June 2, 2010  
JEFFREY S. HSU  
83571

Renewal Date: June 30, 2015

BAGETT - GRIFFITH & BLACKMAN

T11S R39E

E 1/16

S 16

---

S 21

2013

OPLS 83571

I used a steel tape and magnetic compass in the establishment of the accessories. Declination used was 16° East. Distances are taken to a 60d spike in the right hand side of the root crown.

N-12

FILED Dec. 10, 2013  
BAKER COUNTY SURVEYOR  
SURVEY NO. 11-39-189