


CERTIFIED RECORD OF LAND CORNER MONUMENTATION

HISTORY OF ORIGINAL CORNER ESTABLISHMENT:

Originally established by Henry M. Cooke, under G10 contract no. 418, dated August 30, 1881. Surveyor General record states:

- Set a post, 4 ft. long, 4 in. square with marked stone 24 ins. in ground for cor to Sec. 15, 16, 21 and 22, from which:
- A fir, 20 in. dia. bears N70°E, 57 lks. dist., marked T11S R39E S15 BT.
- A fir 20 in. dia. bears N30°W, 62 lks. dist., marked T11S R39E S16 BT.
- A Fir 18 in. dia. bears S84°W, 100 lks. dist., marked T11S R39E S21 BT.
- A Tamarack, 15 in. dia. bears S40°E, 4 lks. dist., marked T11S R39E S22 BT.

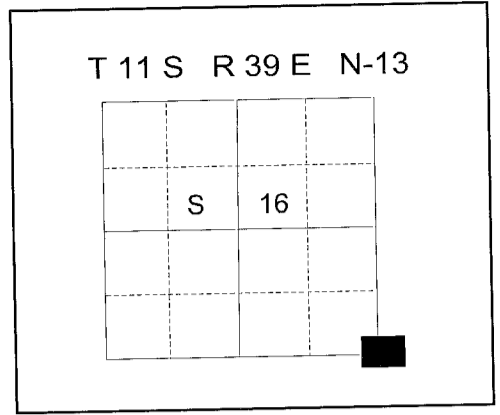

Corner brought to county standard by BLM under special instructions dated May 3, 1957, approved May 6, 1957, under Group No. 350, by Peter A. Peterson, Albert J. Garrison, and Owen C. Chatters, II. Field Notes state:
 The cor. of secs. 15, 16, 21 and 22, determined at record bearing from the remains of the original bearing trees:
 A decayed fir stump, 26 ins. diam., bears N70°E, 57 lks. dist., with scribe marks T11S R390 visible on open blaze.
 A larch, 23 ins. diam., bears S40°E., 4 lks. dist., with healed blaze.
 A fir snag, 27 ins. diam., bears N30°W, 58 lks. dist., with healed blaze.
 At the corner point, set an iron post, 28 ins. long, 2 1/2 ins. diam., 24 ins. in the ground with brass cap, from which new bearing trees:
 A fir, 11 ins. diam., bears N63°E, 12 lks. dist., mkd. T11S R39E S15 BT.
 A fir, 9 ins. diam., bears S64 3/4°W, 16 lks. dist., mkd. T11S R39E S21 BT.
 A fir, 7 ins. diam., bears N72 1/4°W, 14 lks. dist., mkd. T11S R39E S16 BT.

DESCRIPTION OF CORNER EVIDENCE FOUND:

Found 2 1/2" iron pipe with 3" brass cap marked as shown below, flush with the ground, from which:

- A fir stump bears North 70° East, a distance of 37 feet.
- A 24 inch Western larch stump bears South 40° East, a distance of 3 feet.
- A 10 inch fir snag bears South 65° West, a distance of 10.5 feet with scribe marks visible on a partially healed blaze.
- An 8 inch Douglas fir bears North 65° West, a distance of 9.3 feet, alive with dead top and healed blaze.

DESCRIPTION OF MONUMENT AND ACCESSORIES I ESTABLISHED TO PERPETUATE THE ORIGINAL LOCATION OF THIS CORNER: NEW BEARING OBJECTS:


- An 8 inch Douglas Fir bears North 27° East, a distance of 20.85 feet, marked T11S R39E S15 BT.
- A 10 inch Douglas Fir bears South 80° East, a distance of 16.00 feet, marked T11S R39E S22 BT.
- A 12 inch Douglas Fir bears South 84° West, a distance of 16.60 feet, marked T11S R39E S21 BT.

I hereby certify that the corner was perpetuated on November 22, 2013.

REGISTERED
PROFESSIONAL
LAND SURVEYOR

OREGON
June 2, 2010
JEFFREY S. HSU
83571

Renewal Date: June 30, 2015

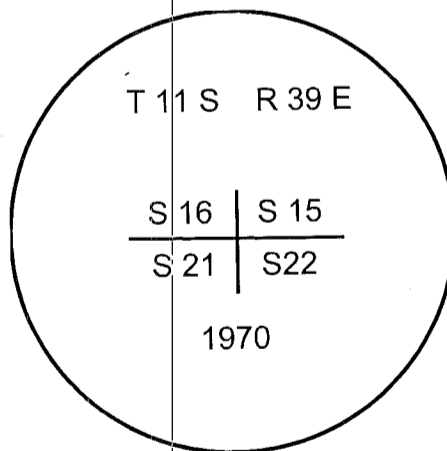

I used a steel tape and magnetic compass in the establishment of the accessories. Declination used was 16° East. Bearings and distances are taken to the center of the tree. On the new bearing trees, distances are taken to a 60d spike in the right hand side of the root crown.

FILED Dec. 10, 2013
 BAKER COUNTY SURVEYOR
 SURVEY NO. 11-39-190