

CERTIFIED RECORD OF LAND CORNER MONUMENTATION

HISTORY OF ORIGINAL CORNER ESTABLISHED:

Corner originally established under GLO contract number 418, executed by Henry W. Cooke, dated August 30th 1881. Surveyor General field notes state:

Set post 3ft long, 3 in. square, with 24 ins in ground for 1/4 sec cor. marked 1/4 on West face from which:

a Pine 40 in. dia. bears North 40° West 118 lks. dist. marked 1/4 S.B.T.

a Tamarack 10 in. dia. bears South 75° East 75 lks. dis. marked 1/4 S.B.T.

Corner remonumented by Peter A. Peterson, Albert J. Garrison, and Owen C. Chatters, under special instruction group number 350, dated May 3rd 1957.

BLM survey record states:


Set an iron post, 28 ins. long, 2 1/2 ins. diam., 20 ins. in the ground, in a mound of stone, 2 ft. base, to top, with brass cap mkd., from which:

A ponderosa pine, 11 ins. diam., bears North 39 1/4° East, 36 lks. dist., mkd. 1/4 S21 BT.

A fir, 9 ins, diam., bears North 25 1/4° West., 161 lks. dist., mkd. 1/4 S20 BT.

Set a steel fence post alongside the iron post.

T 11 S R 39 E P-09

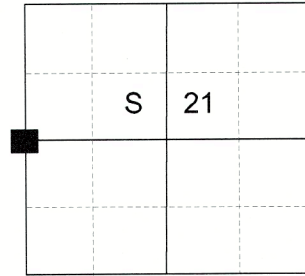

DESCRIPTION OF CORNER EVIDENCE FOUND:

Found a 2 1/2" iron pipe with a 3" "US Dept. of Interior Bureau of Land Management" brass cap, 2" above ground, with 3' mound of stone, from which:

A 23" diam. Ponderosa Pine bears North 39° East, a distance of 23.8 ft., alive and vigorous with healed blaze.

A 15" diam. Douglas Fir bears South 25° West, a distance of 106 ft., alive and vigorous with healed blaze.

Fence post on NE edge, N/S fence line 10' west

DESCRIPTION OF MONUMENT AND ACCESSORIES I ESTABLISHED TO PERPETUATE THE ORIGINAL LOCATION OF THIS CORNER:

From the iron pipe monument:


NEW BEARING OBJECTS:

A 4" diam. Ponderosa Pine bears South 38° East, at a distance of 9.15 feet, marked 1/4 S21 BT.

A 4" diam. Douglas Fir bears South 72° West, at a distance of 7.95 feet, marked 1/4 S20 BT.

I hereby certify that the corner was perpetuated on June 18th, 2024.

Witnesses: Kyle Tucker, Adam Gordon

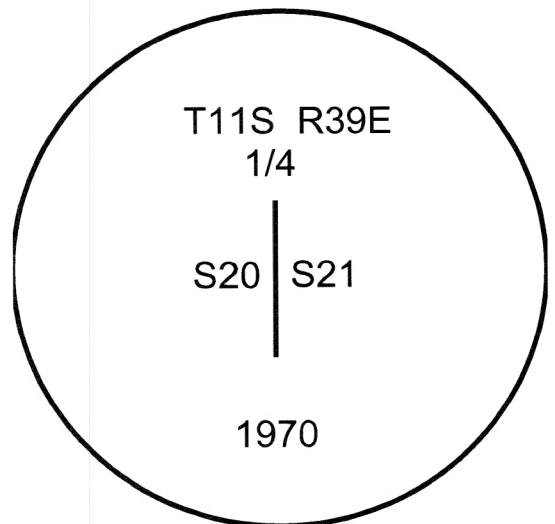

REGISTERED
PROFESSIONAL
LAND SURVEYOR

OREGON
June 2, 2010

JEFFREY S. HSU
83571

Renewal Date: June 30, 2025

I use a tape and compass in the establishment of the new bearing objects. I use 14° East declination. Bearings are measured to a brass washer labeled "OPLS 83571" in the BT blaze at the base of the tree. Distances are to a 60D nail in the right side of the base of the center of the tree.

FILED July 3, 2024
BAKER COUNTY SURVEYOR
SURVEY NO. 11-39-196

P-09