


CERTIFIED RECORD OF LAND CORNER MONUMENTATION

HISTORY OF ORIGINAL CORNER ESTABLISHED:
Corner not previously established

T 11 S R 39 E P-12

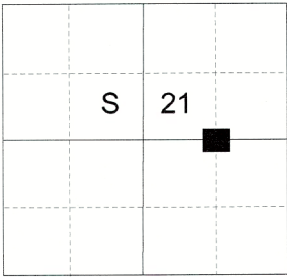

DESCRIPTION OF CORNER EVIDENCE FOUND:
None

DESCRIPTION OF MONUMENT AND ACCESSORIES I ESTABLISHED TO MONUMENT THE ORIGINAL LOCATION OF THIS CORNER:
At position by survey, I set a 5/8" iron pin, 27" in the ground, with 2 1/2" aluminum cap, from which:


NEW BEARING OBJECTS:

A 24" diam. Ponderosa Pine bears North 84° East, a dist. of 24.25 ft, marked CE 1/16 S21 BT
An 8" diam. Ponderosa Pine bears North 33° West, a dist. of 42.05 ft, marked CE 1/16 S21 BT

Set steel fencepost 1 ft. North

I hereby certify that the corner was monumented on June 19th, 2024.

Witnesses: Kyle Tucker, Adam Gordon

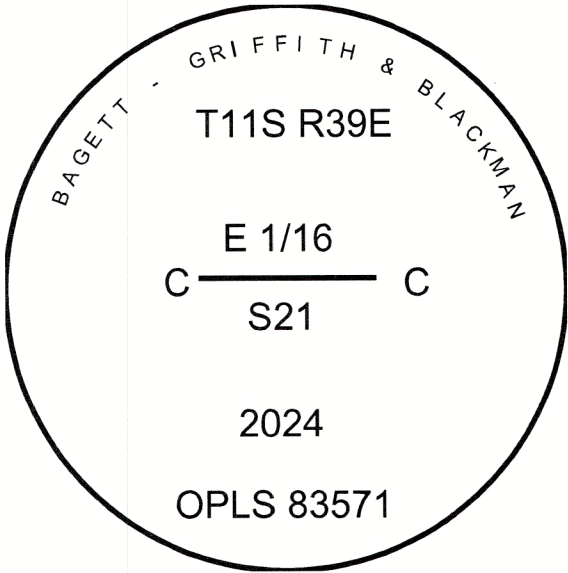

Renewal Date: June 30, 2025

I use a tape and compass in the establishment of the new bearing objects. I use 14° East declination. Bearings are measured to a brass washer labeled "OPLS 83571" in the BT blaze at the base of the tree. Distances are to a 60D nail in the right side of the base of the center of the tree.

FILED July 3, 2024
BAKER COUNTY SURVEYOR
SURVEY NO. 11-39-197