


CERTIFIED RECORD OF LAND CORNER MONUMENTATION

HISTORY OF ORIGINAL CORNER ESTABLISHED:

Corner originally established under GLO contract number 418, executed by Henry W. Cooke, dated August 30th 1881. Surveyor General field notes state:
Set post 3ft long, 3 in. square, with marked stone 12 ins deep for 1/4 sec cor. marked 1/4 S on West side from which:
a Fir 14 in. dia. bears North 88° East 20 lks. dist. marked 1/4 S.B.T.
a Pine 6 in. dia. bears South 88° West 13 lks. dist. marked 1/4 S.B.T.

T 11 S R 39 E P-13

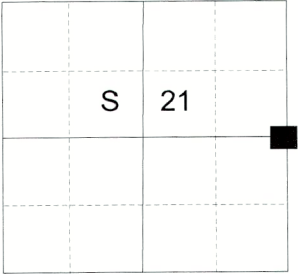

Corner remonumented by Peter A. Peterson, Albert J. Garrison, and Owen C. Chatters, under special instruction group number 350, dated May 3rd 1957. BLM survey record states:
Set an iron post, 28 ins. long, 2 1/2 ins. diam., 20 ins. in the ground, in a mound of stone, 2 ft. base to top, with brass cap mkd. from which:
A ponderosa pine, 12 ins. diam., bears North 41° East, 73 lks. dist., mkd. 1/4 S22 BT.
A fir, 12 ins. diam., bears South 25° West., 104 lks. dist., mkd. 1/4 S21 BT.

DESCRIPTION OF CORNER EVIDENCE FOUND:

Found a 2 1/2" iron pipe with a 3" "US Dept. of Interior Bureau of Land Management" brass cap, 6" above ground , from which:
A 17" diam. Douglas Fir bears South 25° West, a distance of 68.64 ft., alive and vigorous with healed blaze.
A 12" diam. stump bears North 41° East, a distance of 48 feet, with "T" scribe visible on badly deteriorated remains.

Steel fence post falls approx. 3 ft. South

DESCRIPTION OF MONUMENT AND ACCESSORIES I ESTABLISHED TO PERPETUATE THE ORIGINAL LOCATION OF THIS CORNER:


From the iron pipe monument:

NEW BEARING OBJECTS:

A 10" diam. Ponderosa Pine bears North 34° East, a distance of 30.20 feet, marked 1/4 S22 BT.
A 9" diam. Ponderosa Pine bear South 48° East, a distance of 30.75 feet, marked 1/4 S22 BT.
A 6" diam. Ponderosa Pine bears North 51° West, a distance of 28.70 feet, marked 1/4 S21 BT.

Falls on East aspect approx. 40 ft above N/S road.

I hereby certify that the corner was perpetuated on June 18th, 2024.

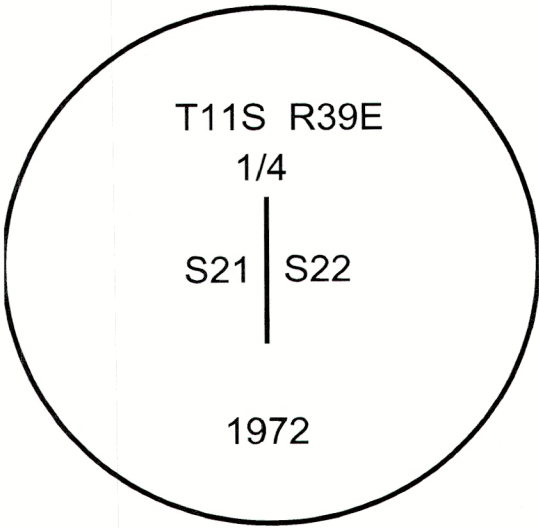

REGISTERED
PROFESSIONAL
LAND SURVEYOR



OREGON
June 2, 2010

JEFFREY S. HSU
83571

Witnesses: Kyle Tucker, Adam Gordon

I use a tape and compass in the establishment of the new bearing objects. I use 14° East declination. Bearings are measured to a brass washer labeled "OPLS 83571" in the BT blaze at the base of the tree. Distances are to a 60D nail in the right side of the base of the center of the tree.

Renewal Date: June 30, 2025

FILED July 3, 2024
BAKER COUNTY SURVEYOR
SURVEY NO. 11-39-198