


CERTIFIED RECORD OF LAND CORNER MONUMENTATION

HISTORY OF ORIGINAL CORNER ESTABLISHED:

Corner originally established under the GLO contract number 418 executed by Henry W. Cooke, dated August 30th 1881. Surveyor General field notes state:
Set post 3ft longs 3 in. square 24 ins deep for 1/4 sec cor. marked 1/4 S on North face, from which:
a Pine 48 in. dia. bears North 75° West 19 lks. dist. marked 1/4 S.B.T.
a Tamarack 28 in. dia. bears South 50° West 36 lks. dist. marked 1/4 S.B.T.

T 11 S R 39 E R-11

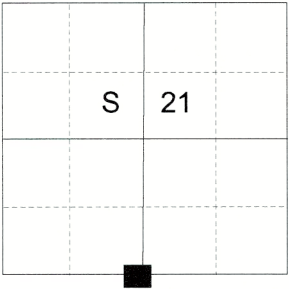

Corner remonumented by Peter A. Peterson, Albert J. Garrison, and Owen C. Chatters, under special instruction group number 350 dated May 3rd 1957. BLM survey record states: Set and iron post, 28 ins. long, 2 1/2 ins. diam., 20 ins. in the ground, in a mound of stone, 2 ft. base, to top, with brass cap mkd. from which:
A grand fir, 13 ins. diam., bears North 77° East, 51 lks. dist., mkd. 1/4 S21 BT.
A grand fir, 3 ins. diam., bears South 27° West., 76 1/2 lks. dist., mkd. X BT.

DESCRIPTION OF CORNER EVIDENCE FOUND:

Found a 2 1/2" iron pipe with a 3" "US Dept. of Interior Bureau of Land Management" brass cap, 3" above ground in 3 ft. mound of stone, from which:
A 10" diam. White Fir bears South 27° West, a distance of 50.5., alive and vigorous with healed blaze.
A 6" diam. White Fir bears North 77° East, a distance of 33.6 ft., alive and vigorous with healed blaze.
Fence post with sign falls approx. 5' North

DESCRIPTION OF MONUMENT AND ACCESSORIES I ESTABLISHED TO PERPETUATE THE ORIGINAL LOCATION OF THIS CORNER:

From the iron pipe monument


NEW BEARING OBJECTS:

A 6" diam. White Fir bears South 2° East, at a distance of 7.00 feet, marked 1/4 S21 BT.
A 35" diam. Ponderosa Pine bears North 45° West, at a distance of 28.90 feet, marked 1/4 S21 BT.

An East/West running fenceline falls approx. 1 ft. South.

I hereby certify that the corner was perpetuated on June 18th, 2024.

Witnesses: Kyle Tucker, Adam Gordon

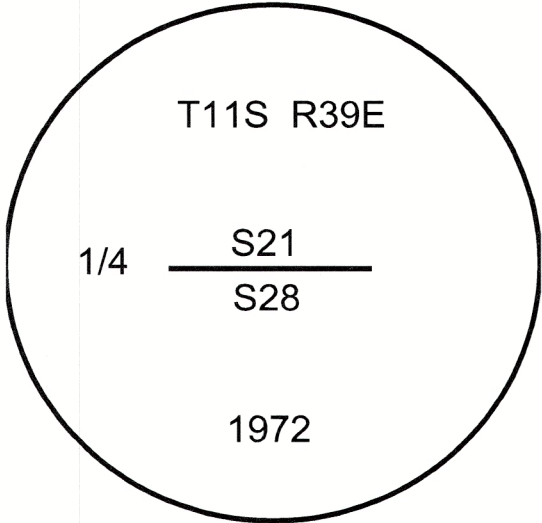

Renewal Date: June 30, 2025

I use a tape and compass in the establishment of the new bearing objects. I use 14° East declination. Bearings are measured to a brass washer labeled "OPLS 83571" in the BT blaze at the base of the tree. Distances are to a 60D nail in the right side of the base of the center of the tree.

FILED July 3, 2024
BAKER COUNTY SURVEYOR
SURVEY NO. 11-39-201