HISTORY

The exterior lines of this T.11S., R.40E., were originally surveyed by Henry W. Cook, in 1882, under General Land Office Contract 418. This Survey is made as a retracement of a previous survey as performed by Benjamin Vaughan in the survey of the West line of T.11S., R.41E., in 1874, under General Land Office Contract No. 211. The 1874 Survey was run South. Cooke ran North with no deviation from the line as run by Vaughn, setting corners on that line which relate to T11S., R40E. After completing the exterior survey of this Township, Cooke then subdivided it under the same contract.

In 1939, Otis O. Gould remonumented original evidence at the SE cor. of 925, the W1/4 cor. 925, and the NE cor. of 925.T11S., R40E., and the NW cor of 930, T11S., R41E., under investigative group No. 163 for the General Land Office.

In 1960, C. Albert White, cadastral surveyor for The Bureau of Land Managment, performed a dependent resurvey of the exterior lines and subdivision of T11S., R41E., under special instructions, group No. 261, dated Sep. 3, 1949, to provide for these surveys. This survey included the retracement of the East line of sections 18 and 25, whereby the East 1/4 of S24, T.11S. R.40E., the West 1/4 of S19 and the West 1/4 of S7, T.11S., R.41E., were determined lost by White and set at proportionate distance. The corners re-monumented by Gould and by White provide the East lines of sections 12 and 25 with angle points along the Range Line as shown.

In 1971, Owen C. Chatters II, cadastral surveyor for The Bureau of Land Managment, remonumented certain original corners in T11S., R40E., under special instructions, group No.350, dated May 3, 1957, to provide for these surveys.

In 1972, Peter A. Peterson, Albert J. Garrison, and Owen C. Chatters, cadastral surveyors for The Bureau of Land Managment, remonumented certain original corners in T11S., R40E., under special instructions, group No.350, dated May 3, 1957, to provide for these surveys.

In 1975, Albert J. Garrison and James J Carlson, cadastral surveyors for The Bureau of Land Managment, remonumented certain original corners in T11S., R40E., under special instructions, group No.350, dated May 3, 1957, to provide for these surveys.

In 1986, William R. Wells and William L. Hanley, under contract for The U.S. Forest Service, set the North 1/16 corner between sections 20 and 21. Refer to Baker County Map Of Survey No. 11-40-79.

MONUMENTATION

See standard U.S.F.S. "INDEX NO." in the circle below and the corresponding circle on this map. (Sheets 1-4). Refer to "CERTIFICD RECORD OF LAND CORNER MONUMENTATION" forms, as referenced to this map of survey and filed in the office of the Baker County Surveyor. Those forms give complete detail as to the HISTORY, (both recorded and un-recorded), pertaining to those corners. The caps are stamped as shown below and the new accessories as required are noted below. This project, being in a recently burnt area, required the use of 1/2"x24" iron pins with 1-1/2" aluminum caps as accessories and are stamped as noted below. In the case where trees are available, painted a 6" red band at breast height around all bearing trees and attatched warning and bearing tree signs as required and a brass washer stamped PLS 848 in the blaze above the "BT." Set steel posts with warning and on boundary signs on the property line each way from the property corners and within 5 ft. of the monument.
Any other work as required is noted below.

E 22	T11S R40E S 1 W1/16 -- S12 1989 PLS 848	Set 1/2"x 24" iron pins with aluminum caps as follows: N86 59'W, 9.9 ft., stamped W 1/16 S1, RM and an arrow with course to monument, 1989 PLS 848. S 8 03'W, 66.81 ft., stamped W1/16 S12, RM and an arrow with course to monument, PLS 848.	
F 23	T11S R40E C N1/16 S12 C 1989 PLS 848	Set 1/2"x 24" iron pins with aluminum caps as follows: S 3 25'E, 13.5 ft., stamped C-N 1/16 S12, RM and an arrow with course to monument, 1989 PLS 848. N80 49'W, 52.00 ft., stamped C-N 1/16 S12, RM and an arrow with course to monument.	
F 25	T11S R40E R41E N1/16 S7 S12 1989 PLS 848	Set 1/2"x 24" iron pins with aluminum caps as follows: N12 52'E, 11.0 ft., stamped N 1/16 S12, RM and an arrow with course to monument, 1989 PLS 848. S49 57'E, 25.80 ft., stamped N 1/16 S7, RM and an arrow with course to monument, PLS 848.	
G 18	T11S R40E W1/16 C--C S11 1989 PLS 848	Set 1/2"x 24" iron pins with aluminum caps as follows: S14 42'W, 9.58 ft., stamped C-W 1/16 S11, RM and an arrow with course to monument, 1989 PLS 848. S77 50'E, 98.74 ft., stamped C-W1/16 S11, RM and an arrow with course to monument, PLS 848.	
G 19	T11S R40E C1/4 S11 1989 PLS 848	Set 1/2"x 24" iron pins with aluminum caps as follows: N48 51'W, 9.4 ft., stamped NW C1/4 S11, RM and an arrow with course to monument, 1989 PLS 848. N45 22'E, 9.50 ft., stamped NE C1/4 S11, RM and an arrow with course to monument, 1989 PLS 848. S46 20'E, 10.1 ft., stamped SE C1/4 S11, RM and an arrow with course to monument, 1989 PLS 848. S61 03'W, 107.03 ft., stamped SW C1/4 S11, RM and an arrow with course to monument, 1989 PLS 848.	
G 23	T11S R40E C1/4 S12 1989 PLS 848	Set 1/2"x 24" iron pins with aluminum caps as follows: N48 35'W, 14.7 ft., stamped NW C1/4 S12, RM and an arrow with course to monument, 1989 PLS 848. N30 11'E, 156.41 ft., stamped NE C1/4 S12, RM and an arrow with course to monument, 1989 PLS 848. S43 11'E, 37.8 ft., stamped SE C1/4 S12, RM and an arrow with course to monument, 1989 PLS 848. S56 30'W, 15.7 ft., stamped SW C1/4 S12, RM and an arrow with course to monument, 1989 PLS 848.	
J 10	T11S R40E S 9 W1/16 -- S16 1989 PLS 848	A pine 12" dia., bears S48 41'W, 1.2 ft, scribed N1/16 S16 BT. A pine 14" dia., bears N34 45'W, 14.5 ft, scribed N1/16 S9 BT. Set 1/2"x 24" iron pin with aluminum cap as follows: S66 05'W, 260.4 ft., stamped W 1/16 S16, RM and an arrow with course to monument, 1989 PLS 848.	
J 12	T11S R40E S 9 E1/16-- S16 1989 PLS 848	Set 1/2"x 24" iron pins with aluminum caps as follows: N35 20'E, 9.33 ft., stamped E 1/16 S9, RM and an arrow with course to monument, 1989 PLS 848. S31 06'E, 54.09 ft., stamped E 1/16 S16, RM and an arrow with course to monument, PLS 848.	
J 16	T11S R40E S10 E1/16-- S15 1989 PLS 848	Set 1/2"x 24" iron pins with aluminum caps as follows: N71 05'E, 9.8 ft., stamped E 1/16 S10, RM and an arrow with course to monument, 1989 PLS 848. S24 26'E, 51.91 ft., stamped E 1/16 S15, RM and an arrow with course to monument, PLS 848.	
J 18	T11S R40E S14 W1/16-- S14 1989 PLS 848	Set 1/2"x 24" iron pins with aluminum caps as follows: S27 09'E, 9.88 ft., stamped W 1/16 S14, RM and an arrow with course to monument, 1989 PLS 848. N56 16'E, 77.89 ft., stamped W 1/16 S14, RM and an arrow with course to monument, PLS 848.	
K 9	T11S R40E N1/16 S17 S16 1989 PLS 848	A pine 12" dia., bears N41 51'E, 19.0 ft, scribed N1/16 S16 BT. A pine 14" dia., bears N87 58'W, 13.5 ft, scribed N1/16 S17 BT. Set 1/2"x 24" iron pin with aluminum caps as follows: S32 03'E, 64.75 ft., stamped N 1/16 S16, RM and an arrow with course to monument, 1989 PLS 848.	
K 10	T11S R40E NW1/16 S16 NW1/16 S16 1989 PLS 848	A pine 12" dia., bears S76 35'W, 8.6 ft, scribed NW1/16 S16 BT. A pine 12" dia., bears S17 51'E, 29.5 ft, scribed NW1/16 S16 BT. Set 1/2"x 24" iron pin with aluminum caps as follows: S37 44'W, 19.46 ft., stamped NW 1/16 S16, RM and an arrow with course to monument, 1989 PLS 848.	
L 11	T11S R40E C1/4 S16 1989 PLS 848	Set 1/2"x24" iron pins with aluminum caps as follows: N37 49'E, 10.5 ft., stamped C1/4 S16, RM and an arrow with course to monument, 1989 PLS 848. S61 45'E, 10.3 ft., stamped C1/4 S16, RM and an arrow with course to monument, 1989 PLS 848. S38 28'W, 10.3 ft., stamped C1/4 S16, RM and an arrow with course to monument, 1989 PLS 848. N77 16'W, 20.07 ft., stamped C1/4 S16, RM and an arrow with course to monument, 1989 PLS 848.	
L 12	T11S R40E E1/16 C--C S16 1989 PLS 848	Set 1/2"x 24" iron pins with aluminum caps as follows: S69 28'E, 10.0 ft., stamped C-E 1/16 S16, RM and an arrow with course to monument, 1989 PLS 848. S59 33'W, 56.49 ft., stamped C-E 1/16 S16, RM and an arrow with course to monument, PLS 848.	
L 15	T11S R40E C1/4 S15 1989 PLS 848	A Lodgepole pine 8" dia., bears S89 21'E, 21.9 ft. scribed C1/4 S15 BT. Set 1/2"x 24" iron pins with aluminum caps as follows: N19 31'E, 10.6 ft., stamped C1/4 S15, RM and an arrow with course to monument, 1989 PLS 848. N86 03'W, 11.5 ft., stamped C1/4 S15, RM and an arrow with course to monument, 1989 PLS 848. S37 38'W, 139.00 ft., stamped C1/4 S15, RM and an arrow with course to monument, 1989 PLS 848.	
L 18	T11S R40E E1/16 C--C S15 1989 PLS 848	Set 1/2"x 24" iron pins with aluminum caps as follows: S42 01'E, 8.95 ft., stamped C-E 1/16 S15, RM and an arrow with course to monument, 1989 PLS 848. N14 23'W, 86.71 ft., stamped C-E 1/16 S15, RM and an arrow with course to monument, PLS 848.	
L 19	T11S R40E C1/4 S14 1989 PLS 848	Set 1/2"x24" iron pins with aluminum caps as follows: N75 09'E, 203.97 ft., stamped C1/4 S14, RM and an arrow with course to monument, 1989 PLS 848. S55 55'E, 10.42 ft., stamped C1/4 S14, RM and an arrow with course to monument, 1989 PLS 848. S54 38'W, 11.73 ft., stamped C1/4 S14, RM and an arrow with course to monument, 1989 PLS 848. N83 52'W, 10.76 ft., stamped C1/4 S14, RM and an arrow with course to monument, 1989 PLS 848.	
L 21	T11S R40E 1/4 S14|S13 1989 PLS 848	Set 1/2"x24" iron pins with aluminum caps as follows: S49 29'E, 8.5 ft., stamped 1/4 S13, RM and an arrow with course to monument, 1989 PLS 848. N85 39'E, 301.60 ft., stamped 1/4 S13, RM and an arrow with course to monument, 1989 PLS 848. S42 10'W, 8.7 ft., stamped 1/4 S14, RM and an arrow with course to monument, 1989 PLS 848. N52 48'W, 8.2 ft., stamped 1/4 S14, RM and an arrow with course to monument, 1989 PLS 848.	
M 9	T11S R40E S1/16 S17|S16 1989 PLS 848	Set 1/2"x24" iron pins with aluminum caps as follows: S86 36'W, 7.55 ft., stamped S1/16 S17, RM and an arrow with course to monument, 1989 PLS 848. S18 39'E, 50.48 ft., stamped S1/16 S17, RM and an arrow with course to monument, 1989 PLS 848.	
M 11	T11S R40E C S1/16|S16 C 1989 PLS 848	Set 1/2"x24" iron pins with aluminum caps as follows: S40 51'E, 8.6 ft., stamped C-S1/16 S16, RM and an arrow with course to monument, 1989 PLS 848. N54 49'W, 25.44 ft., stamped C-S1/16 S16, RM and an arrow with course to monument, 1989 PLS 848.	
M 19	T11S R40E C S1/16|S14 C 1989 PLS 848	Set 1/2"x24" iron pins with aluminum caps as follows: N27 52'W, 11.2 ft., stamped C-S1/16 S14, RM and an arrow with course to monument, 1989 PLS 848. S71 13'W, 47.01 ft., stamped C-S1/16 S14, RM and an arrow with course to monument, 1989 PLS 848.	
M 20	T11S R40E SE1/16 S14 1989 PLS 848	Set 1/2"x24" iron pins with aluminum caps as follows: N49 01'E, 9.6 ft., stamped SE 1/16 S14, RM and an arrow with course to monument, 1989 PLS 848. S35 37'E, 8.73 ft., stamped SE 1/16 S14, RM and an arrow with course to monument, 1989 PLS 848.	
O 12	T11S R40E NE1/16 S21 1989 PLS 848	Set 1/2"x24" iron pins with aluminum caps as follows: N28 15'W, 9.0 ft., stamped NE 1/16 S21, RM and an arrow with course to monument, 1989 PLS 848. S60 13'W, 130.62 ft., stamped NE 1/16 S21, RM and an arrow with course to monument, 1989 PLS 848.	
O 13	T11S R40E N1/16 S21|S22 1989 PLS 848	Set 1/2"x24" iron pins with aluminum caps as follows: N66 05'W, 10.5 ft., stamped N1/16 S21, RM and an arrow with course to monument, 1989 PLS 848. N 8 55'E, 213.31 ft., stamped N1/16 S22, RM and an arrow with course to monument, 1989 PLS 848.	
P 11	T11S R40E 1/4 S21 1989 PLS 848	Set 1/2"x24" iron pins with aluminum caps as follows: N81 45'W, 9.6 ft., stamped C1/4 S21, RM and an arrow with course to monument, 1989 PLS 848. N31 05'E, 8.2 ft., stamped C1/4 S21, RM and an arrow with course to monument, 1989 PLS 848. S61 29'E, 9.0 ft., stamped C1/4 S21, RM and an arrow with course to monument, 1989 PLS 848. S 8 48'W, 197.29 ft., stamped C1/4 S21, RM and an arrow with course to monument, 1989 PLS 848.	
P 12	T11S R40E E1/16 C--C S21 1989 PLS 848	Set 1/2"x24" iron pins with aluminum caps as follows: N20 49'E, 11.0 ft., stamped C-E1/16 S21, RM and an arrow with course to monument, 1989 PLS 848. N67 18'W, 51.83 ft., stamped C-E1/16 S21, RM and an arrow with course to monument, 1989 PLS 848.	
P 13	T11S R40E 1/4 S21|S22 1989 PLS 848	Set 1/2"x24" iron pins with aluminum caps as follows: N57 29'W, 9.6 ft., stamped 1/4 S21, RM and an arrow with course to monument, 1989 PLS 848. N83 58'E, 8.7 ft., stamped 1/4 S22, RM and an arrow with course to monument, 1989 PLS 848. S 4 00'E, 8.0 ft., stamped 1/4 S22, RM and an arrow with course to monument, 1989 PLS 848. S63 22'W, 126.83 ft., stamped 1/4 S21, RM and an arrow with course to monument, 1989 PLS 848.	
P 17	T11S R40E 1/4 S22|S23 1989 PLS 848	Set 1/2"x24" iron pins with aluminum caps as follows: N48 53'W, 10.2 ft., stamped 1/4 S22, RM and an arrow with course to monument, 1989 PLS 848. N54 11'E, 9.6 ft., stamped 1/4 S23, RM and an arrow with course to monument, 1989 PLS 848. S35 24'W, 10.5 ft., stamped 1/4 S22, RM and an arrow with course to monument, 1989 PLS 848. S 8 09'E, 795.93 ft., stamped 1/4 S23, RM and an arrow with course to monument, 1989 PLS 848.	
Q 13	T11S R40E S1/16 S21|S22 1989 PLS 848	Set 1/2"x24" iron pins with aluminum caps as follows: N86 29'W, 9.4 ft., stamped S1/16 S21, RM and an arrow with course to monument, 1989 PLS 848. N30 16'E, 20.39 ft., stamped S1/16 S22, RM and an arrow with course to monument, 1989 PLS 848.	
R 15	T11S R40E S22 1/4-- S27 1989 PLS 848	Set 1/2"x24" iron pins with aluminum caps as follows: N50 40'E, 33.4 ft., stamped 1/4 S22, RM and an arrow with course to monument, 1989 PLS 848. S 1 48'E, 45.5 ft., stamped 1/4 S27, RM and an arrow with course to monument, 1989 PLS 848. N15 31'W, 94.6 ft., stamped 1/4 S22, RM and an arrow with course to monument, 1989 PLS 848. Set aluminum monument S62 13'W, 33.5 stamped as shown and RM and arrow with course to monument, 1989 PLS 848	
R 17	T11S R40E A S22|S23 -- S27|S26 1989 PLS 848	A White Fir 12" dia., bears N17 41'W, 18.6 ft., scribed T11S R40E S22 BT. A White Fir 12" dia., bears S24 19'E, 40.1 ft., scribed T11S R40E S26 BT. A Pond. Pine 9" dia., bears S71 24'W, 34.7 ft., scribed S27 BT. Set 1/2"x24" iron pin with aluminum cap as follows: N23 29'E, 133.40 ft., stamped S23, RM and an arrow with course to monument, 1989 PLS 848	
R 22	T11S R40E S24 W1/16-- S25 1989 PLS 848	Set 1/2"x24" iron pins with aluminum caps as follows: N28 10'W, 9.7 ft., stamped W1/16 S24, RM and an arrow with course to monument, 1989 PLS 848. S42 07'W, 65.80 ft., stamped W1/16 S25, RM and an arrow with course to monument, 1989 PLS 848	
S 13	T11S R40E N1/16 S26|S27 1989 PLS 848	Set 1/2"x24" iron pins with aluminum caps as follows: S77 21'W, 8.2 ft., stamped N1/16 S26, RM and an arrow with course to monument, 1989 PLS 848. S64 22'E, 225.06 ft., stamped N1/16 S27, RM and an arrow with course to monument, 1989 PLS 848	
S 15	T11S R40E C N1/16|S27 C 1989 PLS 848	Set 1/2"x24" iron pins with aluminum caps as follows: N77 44'E, 9.2 ft., stamped C-N1/16 S27, RM and an arrow with course to monument, 1989 PLS 848. N19 52'W, 53.83 ft., stamped C-N1/16 S27, RM and an arrow with course to monument, 1989 PLS 848	
S 17	T11S R40E N1/16 S27|S26 1989 PLS 848	Set 1/2"x24" iron pins with aluminum caps as follows: S85 01'E, 10.0 ft., stamped N1/16 S26, RM and an arrow with course to monument, 1989 PLS 848. S27 49'W, 237.32 ft., stamped N1/16 S27, RM and an arrow with course to monument, 1989 PLS 848	
T 15	T11S R40E C1/4 S27 1989 PLS 848	Set 1/2"x24" iron pins with aluminum caps as follows: N44 22'E, 8.7 ft., stamped C1/4 S27, RM and an arrow with course to monument, 1989 PLS 848. N39 30'W, 8.2 ft., stamped C1/4 S27, RM and an arrow with course to monument, 1989 PLS 848. S40 31'W, 8.3 ft., stamped C1/4 S27, RM and an arrow with course to monument, 1989 PLS 848. S65 37'E, 194.40 ft., stamped C1/4 S27, RM and an arrow with course to monument, 1989 PLS 848.	
T 17	T11S R40E 1/4 S27|S26 1989 PLS 848	Set 1/2"x24" iron pins with aluminum caps as follows: S56 17'W, 8.5 ft., stamped 1/4 S27, RM and an arrow with course to monument, 1989 PLS 848. N39 07'W, 8.2 ft., stamped 1/4 S27, RM and an arrow with course to monument, 1989 PLS 848. S63 02'E, 10.6 ft., stamped C1/4 S26, RM and an arrow with course to monument, 1989 PLS 848. S10 42'E, 58.32 ft., stamped C1/4 S26, RM and an arrow with course to monument, 1989 PLS 848.	
T 19	T11S R40E C1/4 S26 1989 PLS 848	Set 1/2"x24" iron pins with aluminum caps as follows: S40 52'W, 9.3 ft., stamped C1/4 S26, RM and an arrow with course to monument, 1989 PLS 848. S48 08'W, 8.3 ft., stamped C1/4 S26, RM and an arrow with course to monument, 1989 PLS 848. N26 15'W, 9.5 ft., stamped C1/4 S26, RM and an arrow with course to monument, 1989 PLS 848. N64 39'E, 250.90 ft., stamped C1/4 S26, RM and an arrow with course to monument, 1989 PLS 848.	
T 20	T11S R40E E1/16 C--C S26 1989 PLS 848	Set 1/2"x24" iron pins with aluminum caps as follows: N19 44'E, 10.3 ft., stamped C-E1/16 S26, RM and an arrow with course to monument, 1989 PLS 848. N53 53'W, 208.67 ft., stamped C-E1/16 S26 RM and an arrow with course to monument, 1989 PLS 848.	
T 22	T11S R40E W1/16 C--C S25 1989 PLS 848	Set 1/2"x24" iron pins with aluminum caps as follows: N10 50'W 9.4 ft., stamped C-W1/16 S25, RM and an arrow with course to monument, 1989 PLS 848. N52 26'E, 54.06 ft., stamped C-W1/16 S25, RM and an arrow with course to monument, 1989 PLS 848.	
T 23	T11S R40E C1/4 S25 1989 PLS 848	Set 1/2"x24" iron pins with aluminum caps as follows: N33 34'E, 8.6 ft., stamped C1/4 S25, RM and an arrow with course to monument, 1989 PLS 848. N47 17'W, 10 ft., stamped C1/4 S25, RM and an arrow with course to monument, 1989 PLS 848. S46 19'W, 9.2 ft., stamped C1/4 S25, RM and an arrow with course to monument, 1989 PLS 848. S75 41'E, 65.48 ft., stamped C1/4 S25, RM and an arrow with course to monument, 1989 PLS 848.	
U 20	T11S R40E SE1/16 S25 1989 PLS 848	Set 1/2"x24" iron pins with aluminum caps as follows: S26 30'E, 11.0 ft., stamped SE 1/16 S25, RM and an arrow with course to monument, 1989 PLS 848. S76 35'W, 10.59 ft., stamped SE 1/16 S25, RM and an arrow with course to monument, 1989 PLS 848.	
U 21	T11S R40E S1/16 S26|S25 1989 PLS 848	Set 1/2"x24" iron pins with aluminum caps as follows: S16 40'E, 10.3 ft., stamped S1/16 S25, RM and an arrow with course to monument, 1989 PLS 848. N79 11'W, 96.38 ft., stamped S1/16 S25, RM and an arrow with course to monument, 1989 PLS 848.	
U 22	T11S R40E SW1/16 S25 1989 PLS 848	Set 1/2"x24" iron pins with aluminum caps as follows: N59 04'W, 11.1 ft., stamped SW 1/16 S25, RM and an arrow with course to monument, 1989 PLS 848. S46 47'W, 30.27 ft., stamped SW 1/16 S25, RM and an arrow with course to monument, 1989 PLS 848	
V 19	T11S R40E S27 1/4-- S34 1989 PLS 848	Set 1/2"x24" iron pins with aluminum caps as follows: N48 28'E, 8.3 ft., stamped 1/4 S27, RM and an arrow with course to monument, 1989 PLS 848. S47 40'E, 9.9 ft., stamped 1/4 S34, RM and an arrow with course to monument, 1989 PLS 848. S85 35'W, 8.4 ft., stamped 1/4 S34, RM and an arrow with course to monument, 1989 PLS 848. N40 56'W, 137.10 ft., stamped 1/4 S27, RM and an arrow with course to monument, 1989 PLS 848	
V 20	T11S R40E S25 E1/16-- S35 1989 PLS 848	Set 1/2"x24" iron pins with aluminum caps as follows: S31 00'E, 9.4 ft., stamped E1/16 S35, RM and an arrow with course to monument, 1989 PLS 848. N50 34'E, 5.17 ft., stamped E1/16 S25, RM and an arrow with course to monument, 1989 PLS 848	
V 23	T11S R40E S25 1/4-- S35 1989 PLS 848	Set 1/2"x24" iron pins with aluminum caps as follows: N71 52'W, 9.4 ft., stamped 1/4 S25, RM and an arrow with course to monument, 1989 PLS 848. N 8 41'W, 9.6 ft., stamped 1/4 S25, RM and an arrow with course to monument, 1989 PLS 848. S80 31'E, 10.4 ft., stamped 1/4 S36, RM and an arrow with course to monument, 1989 PLS 848. S66 31'W, 131.56 ft., stamped 1/4 S36, RM and an arrow with course to monument, 1989 PLS 848	
X 18	T11S R40E W1/16 C--C S35 1989 PLS 848	Set 1/2"x24" iron pins with aluminum caps as follows: N18 59'W, 8.0 ft., stamped C-W1/16 S35, RM and an arrow with course to monument, 1989 PLS 848. S65 38'W, 156.37 ft., stamped C-W1/16 S35, RM and an arrow with course to monument, 1989 PLS 848	
X 19	T11S R40E C1/4 S35 1989 PLS 848	Set 1/2"x24" iron pins with aluminum caps as follows: N21 44'W, 20.1 ft., stamped C1/4 S35, RM and an arrow with course to monument, 1989 PLS 848. N36 10'E, 10.3 ft., stamped C1/4 S35, RM and an arrow with course to monument, 1989 PLS 848. S50 30'E, 7.9 ft., stamped C1/4 S35, RM and an arrow with course to monument, 1989 PLS 848. S 6 08'W, 94.21 ft., stamped C1/4 S35, RM and an arrow with course to monument, 1989 PLS 848.	
X 20	T11S R40E E1/16 C--C S35 1989 PLS 848	Set 1/2"x24" iron pins with aluminum caps as follows: N35 39'W, 10.8 ft., stamped C-E1/16 S35, RM and an arrow with course to monument, 1989 PLS 848. S 2 54'W, 55.47 ft., stamped C-E1/16 S35, RM and an arrow with course to monument, 1989 PLS 848	

NARRATIVE

This survey was performed under contract for the Wallowa Whitman National Forest, the purpose of which is to establish and mark the Forest boundaries.

In order to perform this survey, the exterior corners for sections 11, 12, 13, 14 and 35, T11S., R40E., were found and these section were subdivided as required. The East 1/4 corner of section 14 was determined to be lost and set by proportionate measure from the found corners one half mile North and South. The East 1/4 corner of section 21 was determined to be lost and set by proportionate measure from the found corners one half mile North and South. The south 1/4 corner of section 23 was determined to be lost and set by proportionate measure from the found corners one half mile East and West. The corner to sections 22, 23, 26, and 27 was determined to be lost and set by double propotionate measure from the found corners one mile North, one mile South, one mile West, and one half mile East. The East 1/4 corner of section 22 was determined to be lost and set by proportionate measure from the proportioned corner one half mile South and the found corner one half mile North. The South 1/4 of section 22 was determined to be lost and set by proportionate measure from the proportioned corner one half mile East and the found corner one half mile West. The East 1/4 corner of section 27 was determined to be lost and set by proportionate measure from the proportioned corner one half mile North and the found corner one half mile South. These sections were then subdivided as required.
All previously set monuments were maintained as required. Positional control for this survey is provided by a closed traverse network. LIETZ SDM 3E electronic tacheater was used to obtian the measurements and a HP-86B computer system was used to perform the computions. a HP VECTRA QS/20 computer system was used for plotting and drafting. Field notes and computations are on file in the office of "FERGUSON SURVEYING & ENGINEERING", Mt. Vernon, OR.

I, Douglas M. Ferguson, Registered Professional Land Surveyor in the State of Oregon, hereby certify that this plat, notes and records hereon or referenced are a correct representation of the survey I performed in Sep. 1989 thru June, 1990, for the U.S. Forest Service in accordance with the statutes of the State of Oregon and the article of my contract, No. 53-0443-2-03353.

Douglas M. Ferguson, OR. PLS 848
Pres., Ferguson Surveying & Engineering

CORNER MAINTENANCE

All previously established corners encountered and shown on this map are maintained as required, thereby new accessories are established and maintained as required, where required to provide a sound monument with proper accessories. All such work is shown on the "CERTIFIED RECORD OF LAND CORNER MONUMENTATION" forms as referenced to this Baker County Map of Survey No. 11-40-126.

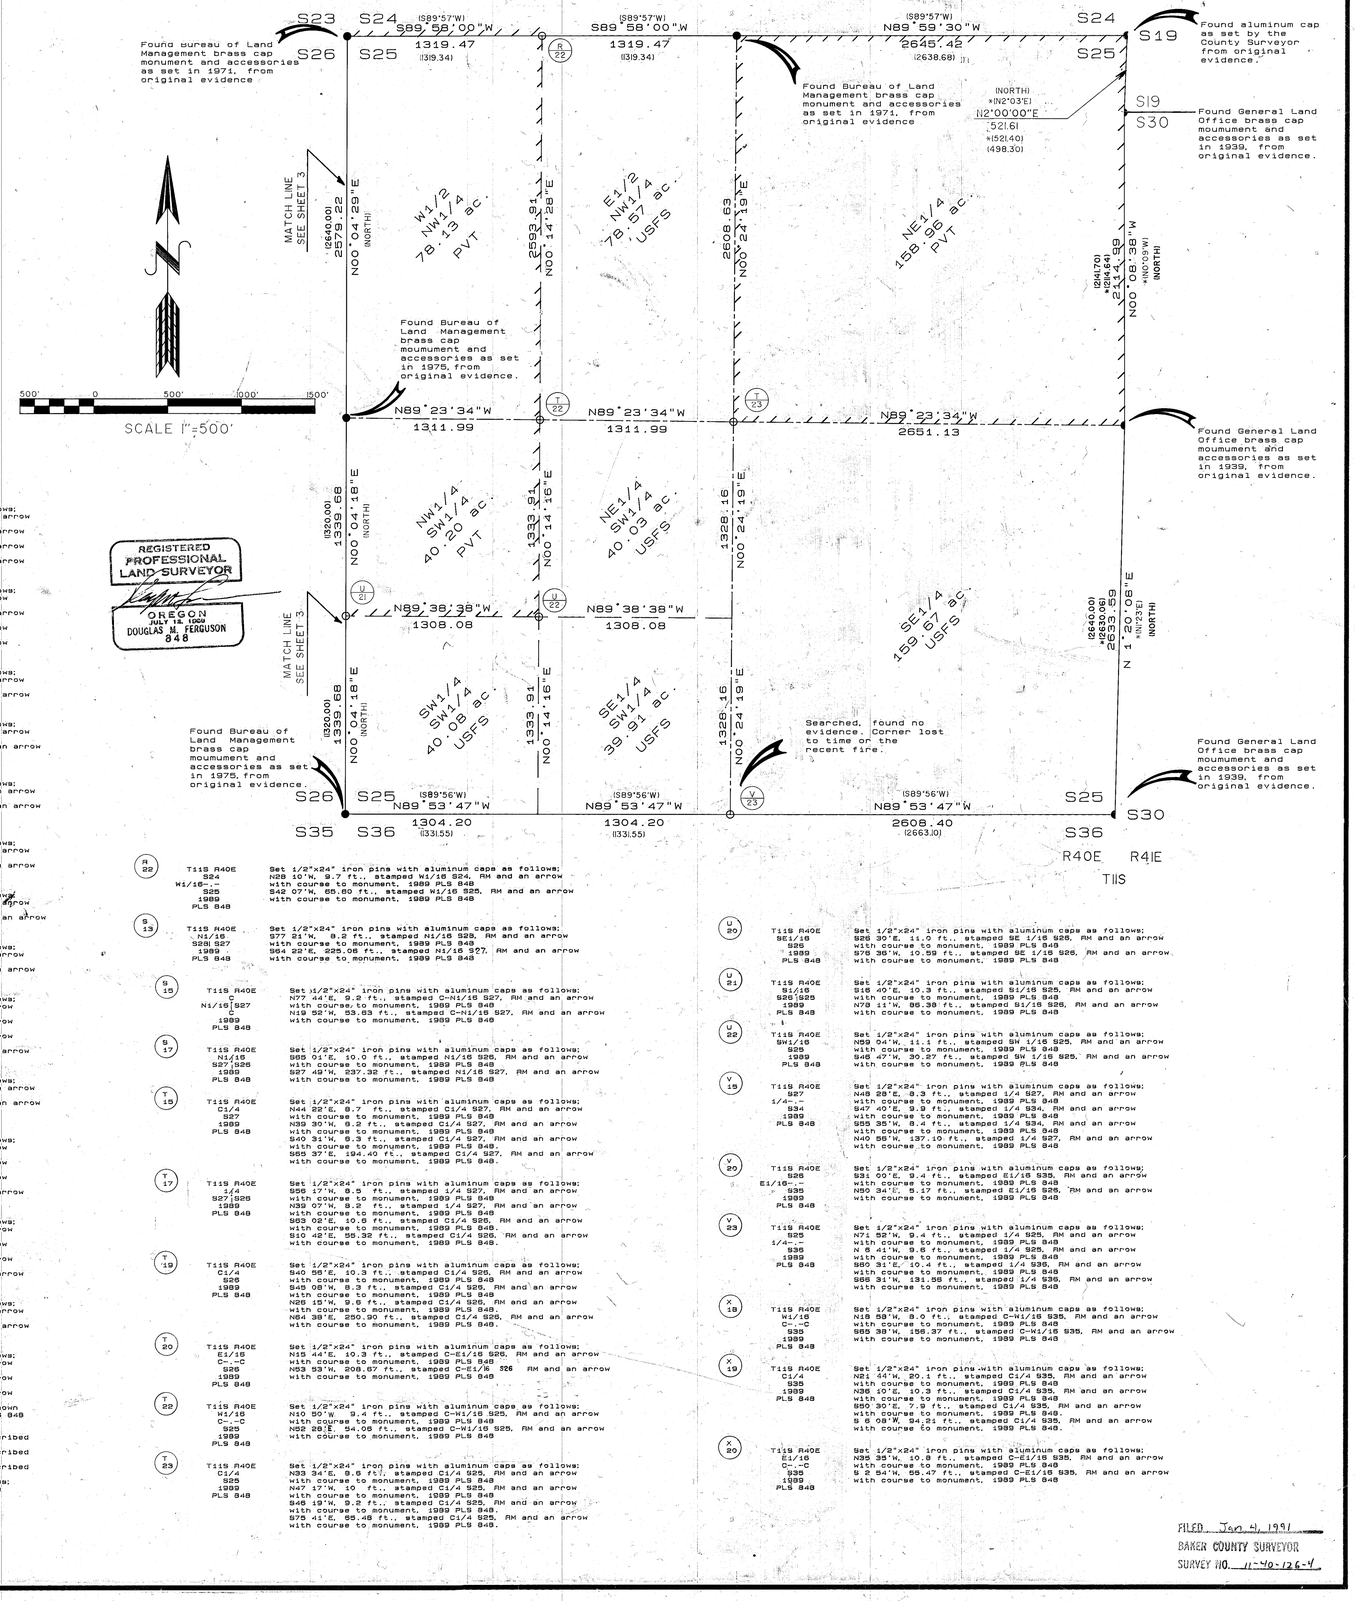

FILED Jan. 4, 1991
BAKER COUNTY SURVEYOR
SURVEY NO. 11-40-126-4

MAP OF SURVEY NO. 11-40-126-4