


**CERTIFIED RECORD OF LAND CORNER MONUMENTATION**

**History of original corner establishment:**

Corner established by Henry W. Cooke under Contract No. 418 dated August 30, 1881.  
 Record states:  
 Set a post 4 ft. long, 4 ins. square 30 ins. in the ground for cor. to sec. 7, 8, 17 and 18, marked with 4 notches on S. and 5 notches on E. edges, T11S S8 on NE, S7 on NW, R40E S18 on SW, S17 on SE faces. Dug pits 18 x 18 x 12 ins. in each sec. 5 1/2 ft. dist. and raised mound of earth 2 ft. high, 4 1/2 ft. diam. base around post.

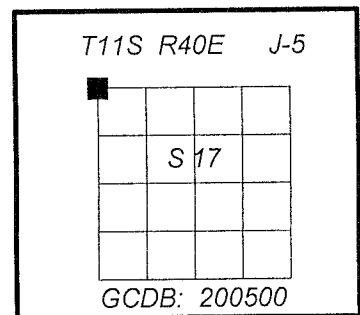

**Subsequent Monumentation:**

Corner remonumented by James Hanley in 1961, recorded in Baker County Survey No. 11-40-3.

Corner maintained by William R. Wells, LS 1106, recorded in 1988 as Baker Co. Survey No. 11-40-88.

**Record states:**

Found a 2 1/2 ins. diam. aluminum cap on 1 1/2 ins. diam. galvanized iron pipe, projecting 10 ins. from a 1 1/2 ft. high, 5 ft. diam. mound of earth.

from which

An unrecorded original BT, 26 ins. diam., ponderosa pine, dead and down, bears S. 72° W., 35.0 ft. dist., with scribe T11S R40E S18 visible on open blaze.

There is also an old 1927 location poster on 14 ins. diam., ponderosa pine, bears S. 70° W., 10.0 ft. dist.

Maintained monument by surrounding with earth and stone. This corner was accepted based on it's location in relation to the unrecorded BT and survey ties to adjacent corners.

**New bearing trees established**

- A ponderosa pine, 17 ins. diam., bears N. 61 1/2° E., 23.2 ft. dist., scribed T11S R40E S8 BT.
- A ponderosa pine, 18 ins. diam., bears S. 7 1/2° E., 5.9 ft. dist., scribed T11S R40E S17 BT.
- A ponderosa pine, 14 ins. diam., bears S. 70° W., 10.7 ft. dist., scribed T11S R40E S18 BT.
- A ponderosa pine, 15 ins. diam., bears N. 35 1/2° W., 60.4 ft. dist., scribed T11S R40E S7 BT.

**Description of corner evidence found:**

Found a 2 1/2 ins. diam. aluminum cap on 1 1/2 ins. diam. galvanized iron pipe, firmly set, projecting 6 ins. above ground with a 3 ft. diam. mound of earth and stone.

from which an original bearing tree as described by Baker Co. Survey No. 11-40-88:


A dead and down ponderosa pine, bears S. 72° W., 35.0 ft. dist., with no visible scribe.  
 and Wells bearing trees

A ponderosa pine snag, 16 ins. diam., bears N. 61 1/2° E., 23.2 ft. dist., with visible scribe T11S R40E S8 BT on open blaze.

A ponderosa pine, 20 ins. diam., alive and healthy, bears S. 7 1/2° E., 5.9 ft. dist., with fragmentary scribe visible on open blaze.

A ponderosa pine, 15 ins. diam., alive and healthy, bears S. 70° W., 10.7 ft. dist., with healed blaze.

A ponderosa pine, 18 ins. diam., alive and healthy, bears N. 35 1/2° W., 60.4 ft. dist., with healed blaze.

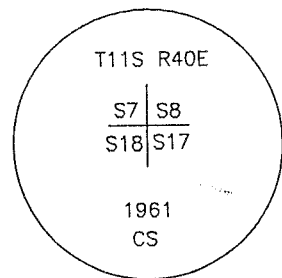

**Description of monument and accessories I established to perpetuate original location of this corner:**

Established new bearing tree

A ponderosa pine, 7 ins. diam., bears N. 28° E., 56.1 ft. dist., scribed T11S R40E S8 BT.

NAD 83 (CORS '96) geographic position:

Lat. 44°36'59.3" N  
 Long. 117°50'58.1" W

All bearing trees are painted with red bands, and have Bearing Tree (54-3) and Land Survey Monument (54-9) signs attached. All new bearing trees have a metal washer stamped "LS 2648" nailed to the side-center.

Posted National Forest Boundary east from corner with Property Boundary (54-2) signs, and a Land Survey Monument (54-9) sign on nearby post.

I hereby certify that the corner was monumented and accessories taken as described, using a staff compass, set with 15 1/2° East declination, and steel tape on 9/ 04/ 2008.

Witnesses: Matthew Brockamp and Dustin Palmer.

REGISTERED  
 PROFESSIONAL  
 LAND SURVEYOR

*[Signature]*  
 OREGON  
 JANUARY 18, 1994  
 RON C. WALTER  
 2648

Renewal Date: June 30, 2010

Office of ..... County Surveyor ..... County of ..... Baker .....  
 State of ..... Oregon ..... , I hereby certify that the within instrument was filed in this office  
 for record on the ..... day of ..... , 20 .....  
 ..... by .....  
 (COUNTY OFFICIAL) (DEPUTY)

FILED DECEMBER 9, 2008