

**CERTIFIED RECORD OF LAND CORNER MONUMENTATION**

**History of original corner establishment:**

Corner monumented by Douglas M. Ferguson, LS 848, recorded in 1991 as Baker Co. Survey No. 11-40-126.

Record states:


Set 2 1/2" x 30" aluminum pipe with 3 1/2" aluminum cap, stamped as shown on the diagram, 28" in the ground.

From which:

A pine, 12 ins. diam., bears S. 48° 41' W., 1.2 ft. dist., scribed W1/16 S16 BT.

A pine, 14 ins. diam., bears N. 34° 45' W., 14.5 ft. dist., scribed W1/16 S9 BT.

A 1/2" x 24" iron pin with aluminum cap as follows; S. 66° 06' W., 128.06 ft., stamped W1/16 S16, RM and an arrow with course to monument, 1989 PLS 848.

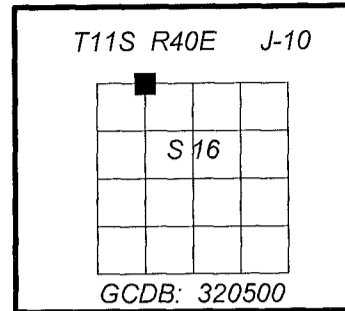

**Description of corner evidence found:**

Found a 2 1/2" x 30" aluminum pipe with 3 1/2" aluminum cap, firmly set flush with ground, stamped as shown on the diagram.

From which:

A pine, 14 ins. diam., alive and healthy, bears S. 48° 41' W., 1.2 ft. dist., with healed blaze.

A pine, 14 ins. diam., bears N. 34° 45' W., 14.5 ft. dist., dead and down.

Record SW RM position falls in new skid trail, Not Found.

**Description of monument and accessories I established to perpetuate original location of this corner:**

Established new bearing tree

A ponderosa pine, 16 ins. diam., bears N. 7° E., 49.6 ft. dist., mkd. W1/16 S9 BT.

NAD 83 (CORS '96) geographic position:

Lat. 44°36'59.9" N


Long. 117°49'29.3" W

All bearing trees are painted with red bands, and have Bearing Tree (54-3) and Land Survey Monument (54-9) signs attached. All new bearing trees have a metal washer stamped "LS 2648" nailed to the side-center.

Posted National Forest Boundary east and south from corner with Property Boundary (54-2) signs, and a Land Survey Monument (54-9) sign on nearby post.

I hereby certify that the corner was monumented and accessories taken as described, using a staff compass, set with 15 1/2° East declination, and steel tape on 9/05/2008.

Witnesses: Matthew Brockamp and Dustin Palmer.

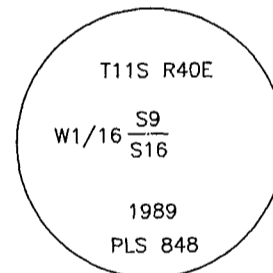

REGISTERED  
PROFESSIONAL  
LAND SURVEYOR

*[Signature]*  
OREGON  
JANUARY 18, 1994  
RON C. WALTER  
2648

Renewal Date: June 30, 2010

Office of ..... County Surveyor ..... County of ..... Baker .....  
State of ..... Oregon ..... , I hereby certify that the within instrument was filed in this office  
for record on the ..... day of ..... , 20 .....  
..... by .....  
(COUNTY OFFICIAL) (DEPUTY)

FILED December 9, 2008

BAKER COUNTY SURVEYOR  
SURVEY NO. 11-40-248