

CERTIFIED RECORD OF LAND CORNER MONUMENTATION

History of original corner establishment:

Corner monumented by Douglas M. Ferguson, LS 848, recorded in 1991 as Baker Co. Survey No. 11-40-126.

Record states;


Set a 2 1/2 ins. diam. by 30 ins. long aluminum pipe with 3 1/2 ins. diam. aluminum cap, stamped as shown.

from which

A pine, 12 ins. diam., bears S. 76° 35' W., 8.6 ft. dist., marked NW 1/16 S16 BT.

A pine, 12 ins. diam., bears S. 17° 51' E., 29.5 ft. dist., marked NW 1/16 S16 BT.

A 1/2" x 24" iron pin with aluminum cap as follows; S. 37° 44' W., 18.46 ft., stamped NW 1/16, RM and an arrow with course to monument, 1989 PLS 848.

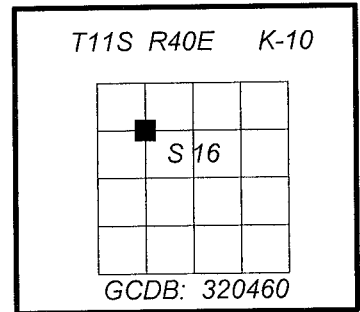

Description of corner evidence found:

Found a 2 1/2" x 30" aluminum pipe with 3 1/2" aluminum cap, stamped as shown on the diagram, firmly set in concrete, 2" above ground, on nw side of fence corner post. Fence corners north and west from monument.

From which Ferguson accessories:

A ponderosa pine, 9 ins. diam., alive and healthy, bears S. 17° 51' E., 29.5 ft. dist., with visible scribe on open blaze.

A ponderosa pine, 11 ins. diam., alive and healthy, bears S. 76° 35' W., 7.6 ft. dist., with visible scribe on open blaze. (Record 8.6 ft. dist.)

A 1/2" x 24" iron pin with aluminum cap as follows; S. 37° 44' W., 18.46 ft., stamped NW 1/16, RM and an arrow with course to monument, 1989 PLS 848.

Description of monument and accessories I established to perpetuate original location of this corner:

NAD 83 (CORS '96) geographic position:


Lat. 44°36'46.3" N
Long. 117°49'27.9" W

All bearing trees are painted with red bands, and have Bearing Tree (54-3) and Land Survey Monument (54-9) signs attached. All new bearing trees have a metal washer stamped "LS 2648" nailed to the side-center.

Posted National Forest Boundary North and West from corner with Property Boundary (54-2) signs, and a Land Survey Monument (54-9) sign on nearby post.

I hereby certify that the corner was monumented and accessories taken as described, using a staff compass, set with 15 1/2° East declination, and steel tape on 9/ 04/ 2008.

Witnesses: Matthew Brockamp and Dustin Palmer.

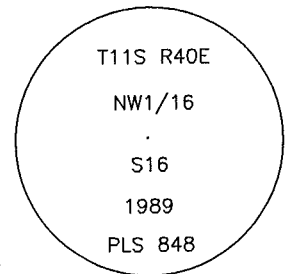

REGISTERED
PROFESSIONAL
LAND SURVEYOR

OREGON
JANUARY 18, 1994
RON C. WALTER
2648

Renewal Date: June 30, 2010

Office of _____ County Surveyor _____ County of _____ Baker
State of _____ Oregon _____, I hereby certify that the within instrument was filed in this office
for record on the _____ day of _____, 20 ____
_____ by _____
(COUNTY OFFICIAL) (DEPUTY)

FILED December 9, 2008