

**CERTIFIED RECORD OF LAND CORNER MONUMENTATION**


**History of original corner establishment:**

Corner established by Henry W. Cooke under Contract No. 418 dated August 30, 1881.  
 Record states:  
 Set a basalt stone 18 x 14 x 12 ins., 12 ins. in the ground for  $\frac{1}{4}$  sec. cor., mkd.  $\frac{1}{4}$  on W. side.  
 from which  
 A pine, 18 ins. diam., bears N. 80° E., 4 lks. dist., mkd.  $\frac{1}{4}$  S BT.  
 A pine, 20 ins. diam., bears S. 75° W., 19 lks. dist., mkd.  $\frac{1}{4}$  S BT.

**Subsequent Monumentation:**


Corner remonumented by James Hanley in 1965, recorded in Baker County Survey No. 11-40-10.  
 record states:  
 Set an iron post alongside quarter cor. stone, 30 ins. long, 1 ins. diam., 18 ins. in the ground with aluminum cap marked  $\frac{1}{4}$  S17, S18 1965, CS.  
 from which  
 A pine, 26 ins. diam., bears N. 80° E., 4 lks. dist., mkd.  $\frac{1}{4}$  S BT.  
 A pine, 26 ins. diam., bears S. 75° W., 19 lks. dist., mkd.  $\frac{1}{4}$  S BT.

Corner remonumented by William L. Hanley, LS 1639, recorded in 1987 as Baker Co. Survey No. 11-40-97.  
 Record states;  
 Found a 2  $\frac{1}{2}$  ins. diam. aluminum cap on 1  $\frac{1}{2}$  ins. diam. galvanized iron pipe, projecting 18 ins. out of ground, with 18 x 14 x 12 ins stone, mkd.  $\frac{1}{4}$ , undisturbed and alongside.  
 from which  
 A sawed stump, bears S. 78° E., 1.6 ft. dist., with visible scribe BT on lower blaze.  
 A sawed stump, bears S. 73° W., 13.7 ft. dist., with long butt alongside with healed blaze.  
 at point of recovered and undisturbed original stone  
 Set a 2  $\frac{1}{2}$  ins. diam. by 30 ins. long aluminum pipe, with 2  $\frac{1}{2}$  ins. diam. aluminum cap, 25 ins. in the ground and surrounded by a mound of earth and stone, mkd. as shown. Removed and buried found aluminum cap alongside.  
 New bearing trees established  
 A ponderosa pine, 9 ins. diam., bears N. 80 $\frac{1}{2}$ ° E., 36.9 ft. dist., scribed  $\frac{1}{4}$  S17 BT.  
 A ponderosa pine, 7 ins. diam., bears S. 73 $\frac{1}{2}$ ° W., 28.7 ft. dist., scribed  $\frac{1}{4}$  S18 BT.

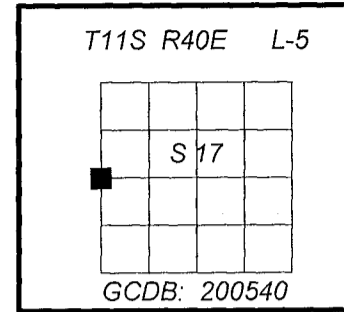

**Description of corner evidence found:**

Found a 2  $\frac{1}{2}$  ins. diam. aluminum cap on 2  $\frac{1}{2}$  ins. diam. aluminum pipe, firmly set, projecting 3 ins. above ground with a rock collar, stamped as shown.  
 from which original bearing trees  
 A sawed stump, 20 ins. diam., bears S. 78° E., 1.6 ft. dist., with partial lower blaze. (GLO and James Hanley record; N. 80° E., 4 lks.)  
 A sawed stump, 18 ins. diam., bears S. 73° W., 13.7 ft. dist., with scribe mks. BT visible on open blaze.  
 and Hanley bearing trees  
 A ponderosa pine, dead and down, bears N. 80 $\frac{1}{2}$ ° E., 36.9 ft. dist.  
 A ponderosa pine, 9 ins. diam., alive and healthy, bears N. 73 $\frac{1}{2}$ ° W., 28.7 ft. dist., with healed blaze.

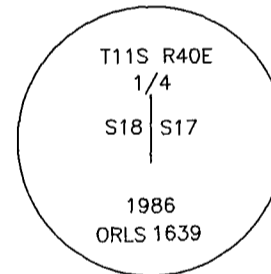

**Description of monument and accessories I established to perpetuate original location of this corner:**

Established new bearing trees  
 A ponderosa pine, 10 ins. diam., bears N. 43° E., 43.6 ft. dist., scribed  $\frac{1}{4}$  S17 BT.  
 A ponderosa pine, 16 ins. diam., bears S. 85° E., 49.3 ft. dist., scribed  $\frac{1}{4}$  S17 BT.  
 A ponderosa pine, 7 ins. diam., bears S. 24° W., 24.6 ft. dist., scribed X BT on double blaze.

NAD 83 (CORS '96) geographic position:  
 Lat. 44°36'33.2" N  
 Long. 117°50'57.4" W

All bearing trees are painted with red bands, and have Bearing Tree (54-3) and Land Survey Monument (54-9) signs attached. All new bearing trees have a metal washer stamped "LS 2648" nailed to the side-center.

Found Property Boundary (54-2) signs, and a Land Survey Monument (54-9) sign on nearby post.

I hereby certify that the corner was monumented and accessories taken as described, using a staff compass, set with 15 $\frac{1}{2}$ ° East declination, and steel tape on 9/04/2008.

Witnesses: Matthew Brockamp and Dustin Palmer.

REGISTERED  
PROFESSIONAL  
LAND SURVEYOR

*Ron C. Walter*  
OREGON  
JANUARY 18, 1994  
RON C. WALTER  
2648

Renewal Date: June 30, 2010

Office of \_\_\_\_\_ County Surveyor \_\_\_\_\_ County of \_\_\_\_\_ Baker \_\_\_\_\_  
 State of \_\_\_\_\_ Oregon \_\_\_\_\_, I hereby certify that the within instrument was filed in this office  
 for record on the \_\_\_\_\_ day of \_\_\_\_\_, 20 \_\_\_\_\_  
 \_\_\_\_\_ by \_\_\_\_\_  
 (COUNTY OFFICIAL) (DEPUTY)

FILED December 9, 2008