


CERTIFIED RECORD OF LAND CORNER MONUMENTATION

Corner not previously monumented:


No record of corner being previously monumented. The position of this corner is established by the methods and procedures defined in the U.S. Bureau of Land Management, Manual of Survey Instructions '73 (Manual), and as shown on Record of Survey filed with the Baker County Surveyor.

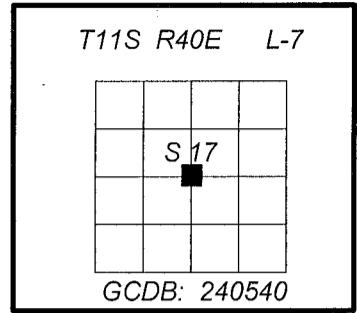

Description of corner evidence found:

Found a NOT OF RECORD 2 1/2" aluminum pipe with standard F.S. 3 1/4" aluminum cap, marked LS 1921 (Jasper M. Sams) Dated 1993, firmly set flush with ground, with rock collar, stamped as shown on the diagram. This corner was accepted as the C 1/4 by the Record of Survey referenced above.

- from which
- A ponderosa pine snag, 8 ins. diam., bears N. 36° E., 38.9 ft. dist., with visible scribe on opened blaze.
- A Douglas fir, 19 ins. diam., alive and healthy, bears S. 61° E., 70.5 ft. dist., with healed blaze.
- A Douglas fir, 21 ins. diam., alive and healthy, bears S. 78 1/2° W., 111.1 ft. dist., with healed blaze.
- A ponderosa pine, 19 ins. diam., alive and healthy, bears N. 41° E., 109.7 ft. dist., with healed blaze.

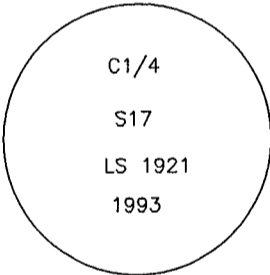

Description of monument and accessories I established to perpetuate original location of this corner:

Established new bearing tree
 A Douglas fir, 13 ins. diam., bears N. 50 1/2° E., 78.3 ft. dist., scribed C 1/4 S17 BT.

NAD 83 (CORS '96) geographic position:
 Lat. 44°36'33.4" N
 Long. 117°50'22.6" W

All bearing trees are painted with red bands, and have Bearing Tree (54-3) and Land Survey Monument (54-9) signs attached. All new bearing trees have a metal washer stamped "LS 2648" nailed to the side-center.

Posted National Forest Boundary North and East from corner with Property Boundary (54-2) signs, and a Land Survey Monument (54-9) sign on nearby post.

I hereby certify that the corner was monumented and accessories taken as described, using a staff compass, set with 15 1/2° East declination, and steel tape on 9/ 05/ 2008.

Witnesses: Matthew Brockamp and Dustin Palmer.

REGISTERED
 PROFESSIONAL
 LAND SURVEYOR

Ron C. Walter
 OREGON
 JANUARY 18, 1994
 RON C. WALTER
 2648

Renewal Date: June 30, 2010

Office of County Surveyor County of Baker
 State of Oregon , I hereby certify that the within instrument was filed in this office
 for record on the day of , 20
 by
 (COUNTY OFFICIAL) (DEPUTY)

FILED DECEMBER 9, 2008