

CERTIFIED RECORD OF LAND CORNER MONUMENTATION

History of original corner establishment:

Corner established by Henry W. Cooke under Contract No. 418 dated August 30, 1881.
 Record states:
 Set a post 3 ft. long, 3 ins. square 24 ins. in the ground for 1/4 sec. cor. marked 1/4 S on W. face.
 from which

- A pine, 20 ins. diam., bears S. 60° E., 73 lks. dist., marked 1/4 S BT.
- A fir, 12 ins. diam., bears N. 68° W., 48 lks. dist., marked 1/4 S BT.

Subsequent Monumentation:

Corner remonumented BLM cadastral surveyor, A. Joseph Garrison, under special instructions dated May 3, 1957, and approved June 13, 1977.
 record states

The 1/4 sec. cor. of secs. 16 and 17, determined at record bearing and distance from the remains of the original bearing trees

- A sawed and decayed pine stump, 17 ins. diam., bears S. 60° E., 73 lks. dist, with scribe mks. BT visible on open blaze.
- A sawed and decayed pine stump, 18 ins. diam., bears N. 68° W., 48 lks. dist, with scribe mks. 1/4 S visible on upper blaze, and with healed lower blaze.

at the corner point

Set an iron post 28 ins. long, 2 1/2 ins. diam., 24 ins. in ground, with brass cap mkd. as shown.
 from which

- A fir, 12 ins. diam., bears N. 52 1/2° E., 30 lks. dist., mkd. 1/4 S16 BT.
- A pine, 16 ins. diam., bears N. 67 3/4° W., 36 lks. dist., mkd. 1/4 S17 BT.

Corner maintained by William R. Wells, LS 1106, recorded in 1986 as Baker Co. Survey No. 11-40-98.
 Record states;

Found a 3 ins. diam. BLM brass cap on 2 1/2 ins. diam. galvanized iron pipe, projecting 3 ins. from mound of earth and stone.
 from which

- A sawed rotten, 17 ins. diam., pine stump, bears S. 58 1/2° E., 48.9 ft. dist., with visible scribes. (record S. 60° E.)
- A sawed rotten, 18 ins. diam., pine stump, bears N. 68° W., 31.7 ft. dist., with visible scribes.
- A 13 ins. diam., Douglas fir, bears N. 52 1/2° E., 19.8 ft. dist., visible scribing on partially healed blaze.
- An 18 ins. diam., ponderosa pine, bears N. 65° W., (record N. 67 3/4° W.), 23.8 ft. dist., with visible scribe on partially healed blaze.

new bearing tree established

- A ponderosa pine, 8 ins. diam., bears S. 25° E., 65.8 ft. dist., scribed 1/4 S16 BT.

Corner maintained by Douglas M. Ferguson, LS 848, recorded in 1991 as Baker Co. Survey No. 11-40-155.
 record states;

Found a 3 ins. diam. BLM brass cap on 2 1/2 ins. diam. galvanized iron pipe.
 From which

- A pine, 22 ins. diam., bears N. 67°-42' W., 24.1 ft. dist., in good condition.

New RM's established

- A 1/2" x 24" iron pin with aluminum cap bears S. 80°-45' E., 9.3 ft. dist., stamped 1/4 S 16 RM, with arrow and course to the corner
- bears N. 33°-30' W., 9.8 ft. dist., stamped 1/4 S 17 RM, with arrow and course to the corner
- bears S. 30°-00' E., 84.78 ft. dist., stamped 1/4 S 16 RM, with arrow and course to the corner

Description of corner evidence found:

Found a 2 1/2" x 28" galvanized iron pipe with standard BLM 3 1/4" brass cap, stamped as shown on the diagram, firmly set in concrete, 6" above ground, on SE side of fence corner post. Note: monument is reset with cap oriented to the south.
 from which original bearing trees

- A decayed cut pine stump, bears S. 58 1/2° E., 48.9 ft. dist., with visible scribe BT on open blaze.
- A decayed cut pine stump, bears N. 68° W., 31.7 ft. dist., with visible scribe BT on open blaze.
- and BLM bearing trees
- A Douglas fir, dead and down, bears N. 52 1/2° E., 19.8 ft. dist., with visible scribe on open blaze.
- A ponderosa pine, 24 ins. diam., alive and healthy, bears N. 67 3/4° W., 24.1 ft. dist., with healed blaze.
- and Wells bearing tree
- A ponderosa pine, dead and down, bears S. 25° E., 65.8 ft. dist., with visible scribe on open blaze.
- and Ferguson reference monuments
- A 1/2 ins. diam. iron rod with 1 1/2 ins. diam. aluminum cap, bears S. 30° E., 84.7 ft. dist., mkd. RM 1990 PLS 848 with arrow and course to monument.
- A 1/2 ins. diam. iron rod with 1 1/2 ins. diam. aluminum cap, bears N. 33° 30' W., 9.8 ft. dist., mkd. RM 1990 PLS 848 with arrow and course to monument.

Description of monument and accessories I established to perpetuate original location of this corner:

Established new bearing trees
 A ponderosa pine, 10 ins. diam., bears N. 33° E., 24.2 ft. dist., scribed 1/4 S16 BT.
 A fir, 11 ins. diam., bears S. 22 1/2° W., 79.9 ft. dist., scribed 1/4 S17 BT.



NAD 83 (CORS '96) geographic position:
 Lat. 44°36'33.2" N
 Long. 117°49'47.0" W

All bearing trees are painted with red bands, and have Bearing Tree (54-3) and Land Survey Monument (54-9) signs attached. All new bearing trees have a metal washer stamped "LS 2648" nailed to the side-center.
 Posted National Forest Boundary North and West from corner with Property Boundary (54-2) signs, and a Land Survey Monument (54-9) sign on nearby post.

I hereby certify that the corner was monumented and accessories taken as described, using a staff compass, set with 15 1/2° East declination, and steel tape on 9/04/2008.
 Witnesses: Matthew Brockamp and Dustin Palmer.

Office of County Surveyor County of Baker
 State of Oregon , I hereby certify that the within instrument was filed in this office
 for record on the day of , 20
 by
 (COUNTY OFFICIAL) (DEPUTY)

FILED DECEMBER 9, 2008

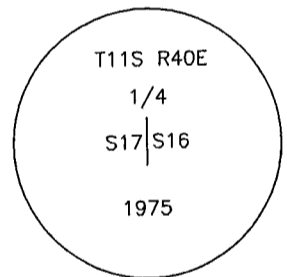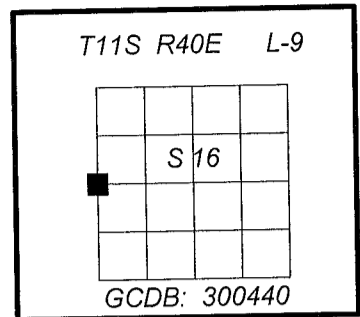

REGISTERED
 PROFESSIONAL
 LAND SURVEYOR

[Signature]
 OREGON
 JANUARY 18, 1994
 RON C. WALTER
 2648

Renewal Date: June 30, 2010