

CERTIFIED RECORD OF LAND CORNER MONUMENTATION

INDEX NO. P-3

History of original corner establishment:
Baker County Survey Records show no previous
establishment of this corner.

DIAGRAM
T11S R41E
C1/4
S19
1989
PLS 848


Description of corner evidence found:
Baker County Survey Records show no previous
establishment of this corner.

Description of monument and accessories I established
to perpetuate the original location of this corner:
Set 2-1/2"x30" aluminum pipe with 3-1/2" aluminum cap, stamped as shown
on the DIAGRAM, Set 27" in the ground.

From Which:

A W. Fir 12" diam. bears S85 39'W., 12.7, scribed C1/4 S19 BT
A W. Fir 10" diam. bears N21 22'W., 26.9, scribed C1/4 S19 BT
A P.Pine 8" diam. bears N69 33'E., 10.6, scribed C1/4 S19 BT
Set 1/2"x24" iron pins with aluminum caps, as follows:
S06 29'E., 50.73 ft., stamped C1/4 S19 RM and arrow with
course to the corner and 1989, PLS 848. This Pin is part of the
survey control network. Set a steel post with warning sign
alongside this pin.

Measurements to accessories taken with electronic tachimeter with
angles turned from the survey control network. Set steel fence posts
with Warning and Boundary signs 2 ft. East & 4 ft. West from the
monument.

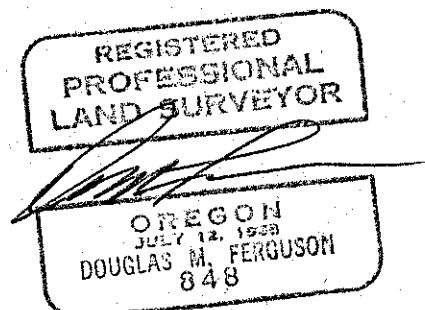

This work is performed by:
Douglas M. Ferguson PLS 848
D. Mitchell Ferguson & Ken H. Delano
On Nov. 11, 1989
Refer to Baker Co. Survey No. 11-41-1

Office of _____ County of _____
State of _____ I hereby certify that the within instrument was filed
in this office for record on the _____ day of _____, 19_____
by _____

(COUNTY OFFICIAL)

(DEPUTY)

FILED Jan. 4, 1991
BAKER COUNTY SURVEYOR
SURVEY NO. 11-41-9