

CERTIFIED RECORD OF LAND CORNER MONUMENTATION

INDEX No. R-3

History of original corner establishment:
Corner was originally established in 1874
by Benjamin Vaughan, under General Land
Office Contract No. 211. Surveyor General
notes state: Set stone 12x10x10 for 1/4
sec. corner.

In 1960, C. Albert White, Cadastral Surveyor for The Bureau Of Land
Managment, under special instructions, group No. 261, dated Sep. 3,
1940, approved Jan. 16, 1941, and assignment instructions dated
May 5, 1960, re-monumented this corner at proportionate distance.

DIAGRAM



S19
1/4---
S30
T11S R41E
1960
BLM CAP

Description of corner evidence found:

Found 2-1/2" iron pipe with 3" brass cap stamped as shown in the
DIAGRAM. Corner monument is solid and in good condition.
Found bearing tree as established by C. Albert White
Pine 12 ins. dia. bears N24E, 11.5 ft., 1/4 S19 BT

Description of monument and accessories I established
to perpetuate the original location of this corner:

New bearing trees,
A LP. Pine 12" Diam. bears N58W, 26.0 ft., scribed 1/4 S19 BT.
A LP. Pine 8" Diam. bears S 6E, 14.2 ft., scribed 1/4 S30 BT.
A W. Fir 6ins. diam. bears S53W, 16.2, scribed 1/4 S30 BT.
Measurement to trees taken with compass in both directions.
Declination 19 1/2 deg. East. Set steel post with warning sign 5'
North.

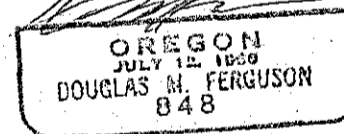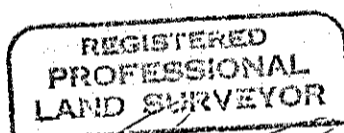

This work is performed by:
Douglas M. Ferguson PLS 848
D. Mitchell Ferguson & Ken H. Delano
On June 8, 1990
Refer to Baker Co. Survey No. 11-41-1

Office of _____ County of _____
State of _____ I hereby certify that the within instrument was filed
in this office for record on the _____ day of _____, 19____

(COUNTY OFFICIAL)

(DEPUTY)

FILED Jan. 4, 1991
BAKER COUNTY SURVEYOR
SURVEY NO. 11-41-12