

CERTIFIED RECORD OF LAND CORNER MONUMENTATION

INDEX No. V-1

History of original corner establishment:
Corner was originally established in 1874
by Benjamin Vaughan, under General Land
Office Contract No. 211. Surveyor General
notes state: Set stone 16x10x14 for cor.
secs. 30, 31, 25, 36 from which:

A Pine 15 ins. diam. bears N45W 251ks dist.

DIAGRAM

T11S T11S

R40E S30

S36+--

1931

R41E

1960

(BLM CAP)

A Pine 25 ins. diam. bears N30E 401ks dist.

In 1960, C. Albert White, Cadastral Surveyor for The Bureau Of Land Management, under special instructions, group No. 261, dated Sept. 3, 1940, approved Jan. 16, 1941, and assignment instructions dated May 5, 1960, re-monumented this corner at proportionate distance.

Description of corner evidence found:

Found 2-1/2" iron pipe with 3" brass cap stamped as shown in the DIAGRAM. Corner monument is solid and in good condition.

All previously established accessories have been rendered useless in the long term by the 1989 fire. Refer to the above referenced notes.

Description of monument and accessories I established to perpetuate the original location of this corner:

New BT's:

A P.Pine 8 ins. diam. bears N65 30'W, 62.7 ft., scribed T11S R40E S36 BT.



A P.Pine 12 ins. diam. bears S14 15'E, 120.4 ft., scribed T11S R41E S31 BT.

A W. Fir 12 ins. diam. bears S36W, 27.2 ft., scribed T11S R40E S36 BT.

Set 1/2" x 24" iron pin with aluminum cap as follows:

N33-30'E, 11.6 ft., stamped S30, RM with an arrow and course to the corner.

Measurement to accessories taken with compass in both directions.

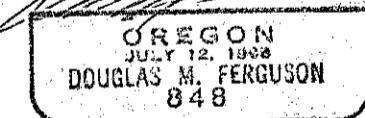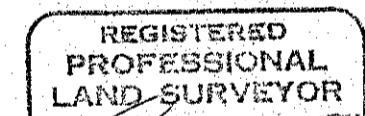

This work is performed by:

Douglas M. Ferguson PLS 848

D.Mitchell Ferguson & Ken H. Delano

On June 6, 1990

Refer to Baker Co. Survey No. 11-41-1

Office of _____ County of _____
State of _____ I hereby certify that the within instrument was filed
in this office for record on the _____ day of _____, 19_____
by _____

(COUNTY OFFICIAL)

(DEPUTY)

FILED Jan 4 1991

BAKER COUNTY SURVEYOR

SURVEY NO. 11-41-14