

CERTIFIED RECORD OF LAND CORNER MONUMENTATION


**HISTORY OF ORIGINAL CORNER ESTABLISHMENT:**

None.

No record of subsequent monumentation found in Baker County survey records

**DESCRIPTION OF CORNER EVIDENCE FOUND:**

None.

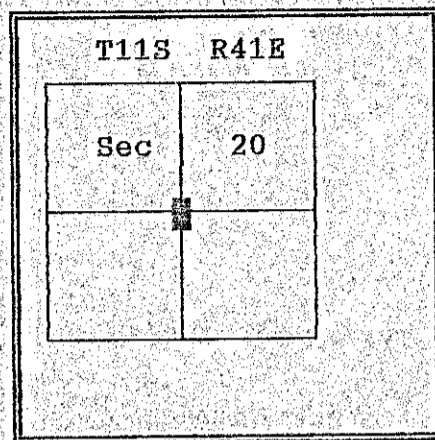

DIAGRAM

**DESCRIPTION OF MONUMENT AND ACCESSORIES I ESTABLISHED TO PERPETUATE THE ORIGINAL LOCATION OF THIS CORNER:**

At position determined by survey, I set a 2½" x 30" aluminum pipe with aluminum cap marked as shown, 24 inches in the ground, from which;

**NEW BEARING TREES:**

- A 15 inch diameter White Fir bears N72°E, 54.25 feet marked C 1/4 S20 BT.
- A 9 inch diameter Douglas Fir bears S23°E, 63.18 feet marked C 1/4 S20 BT.
- A 20 inch diameter Ponderosa Pine bears S29°W, 84.60 feet marked XT BT.
- A 20 inch diameter Ponderosa Pine bears N78°W, 8.19 feet marked C 1/4 S20 BT.

Raised a mound of stone around monument, 1.5 ft. base to top of cap.

Painted a 6" red band around all BTs and attached Bearing Tree signs.


Set a steel fence post approximately 5 feet North with Land Survey Monument sign attached.

I hereby certify that the above corner point was perpetuated as hereon described on August 2, 1994.  
Witnesses: Peter Crabtree and Travis Foster.

REGISTERED  
PROFESSIONAL  
LAND SURVEYOR

*Jeffery P. Petersen*

OREGON  
JEFFERY P. PETERSEN  
2625  
JULY 20, 1993

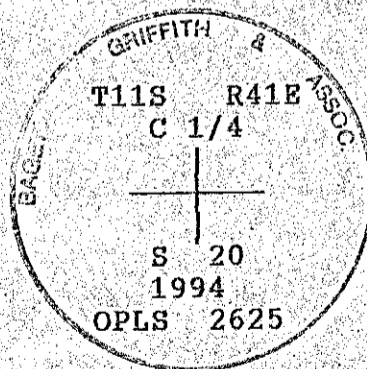

I used a steel tape and magnetic compass in the establishment of new accessories. I used 20° East magnetic declination and the distances are to a 50d spike driven in the right side of the root crown.

P-7

FILED 8-24-94

BAKER COUNTY SURVEYOR  
SURVEY NO. 11-21-17