

CERTIFIED RECORD OF LAND CORNER MONUMENTATION

HISTORY OF ORIGINAL CORNER ESTABLISHMENT:

Originally established by Benjamin Vaughn under GLO Contract No. 211, dated July 14, 1874. Surveyor record states:


Set Stone 12x10x8 for 1/4 Sec. Cor.

Reestablished at proportionate position by C. Albert White under special instructions dated September 3, 1940, included under Group No. 261. Surveyor record states:

Set an iron post, 28 ins. long, 2 1/2 ins. diam., 22 ins. in the ground, from which:

A yellow pine, 8 ins. diam., bears N. 19° W., 40 lks. dist., mkd. 1/4 S16 BT.

A yellow pine, 6 ins. diam., bears S. 66° E., 35 lks. dist., mkd. 1/4 S21 BT.

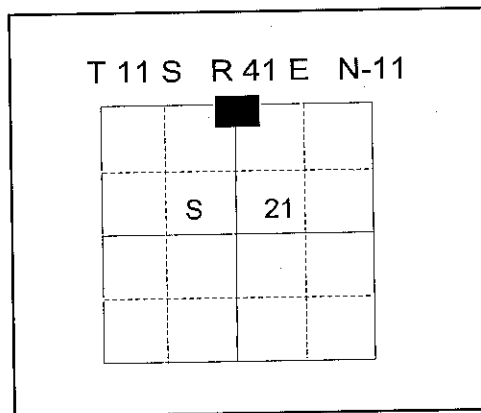

DESCRIPTION OF CORNER EVIDENCE FOUND:

Found Bureau of Land Management 3" Brass cap on 2 1/2" iron post, protruding 10" above ground, there are no remaining accessories.

DESCRIPTION OF MONUMENT AND ACCESSORIES I ESTABLISHED

TO PERPETUATE THE ORIGINAL LOCATION OF THIS CORNER:

NEW BEARING TREES:

- A 16 in. Ponderosa Pine bears North 73° East, a distance of 71.25 feet, marked 1/4 S16 BT.
- A 5 in. Ponderosa Pine bears South 40° East, a distance of 18.49 feet, marked X BT.
- A 13 in. Ponderosa Pine bears South 30° West, a distance of 44.06 feet, marked 1/4 S21 BT.
- A 4 in. Ponderosa Pine bears North 77° West, a distance of 15.80 feet, marked X BT.

Set steel fence post approximately 1 ft. North with Land Survey Monument sign


I hereby certify that the corner was perpetuated on July 6, 2009

Witness: Jeff Hsu

REGISTERED
PROFESSIONAL
LAND SURVEYOR

Rick G. Robinson
OREGON
July 17, 1986
RICK G. ROBINSON
2219

Renewal Date: December 31, 2010

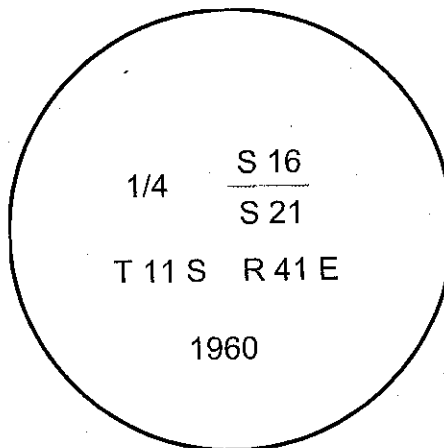

I used a steel tape and magnetic compass in the establishment of the bearing trees. I used 18° East declination. I attached a brass washer marked OPLS 2219 to the BT blaze. The distance is to a 60d spike driven into the root crown at the right side of the new bearing trees.

FILED Sept. 4, 2009
BAKER COUNTY SURVEYOR
SURVEY NO. 11-41-20