

CERTIFIED RECORD OF LAND CORNER MONUMENTATION


HISTORY OF ORIGINAL CORNER ESTABLISHMENT:

Originally established by C. Albert White under special instructions dated September 3, 1940, included under Group No. 261. Surveyor record states:

Set an iron post, 28 ins. long, 2 1/2 ins. diam., 21 ins. in the ground, from which:

A yellow pine, 20 ins. diam., bears N. 23° W., 89 lks. dist., mkd. E 1/16 S16 BT.

A yellow pine, 8 ins. diam., bears S. 76° E., 26 lks. dist., mkd. E 1/16 S21 BT.

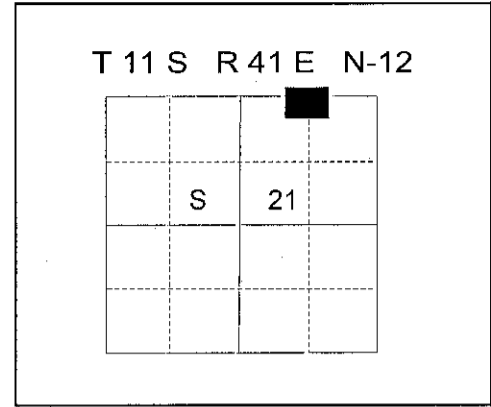

DESCRIPTION OF CORNER EVIDENCE FOUND:

Found Bureau of Land Management 3" Brass cap on 2 1/2" iron post, protruding 12" above ground, from which:

A pine stump, width indeterminate, bears South 75° East, a distance of 17.65 ft., with visible scribe marks on remnant next to stump.

The root hole of a 20" pine log, dead and downed, bears North 17° West, a distance of 59.0 feet.

DESCRIPTION OF MONUMENT AND ACCESSORIES I ESTABLISHED

TO PERPETUATE THE ORIGINAL LOCATION OF THIS CORNER:

NEW BEARING OBJECTS:

A 7 in. Ponderosa Pine bears South 30° East, a distance of 21.38 feet, marked E 1/16 S21 BT.

A 5/8" x 30" iron pin bears South 56° West, a distance of 7.03 feet, with 1 1/2" Aluminum cap marked BGB SURVEY MARKER SW RP. Set a steel fencepost with Land Survey Monument sign 0.5 ft. Southwesterly of pin.

Set a steel fencepost with Land Survey Monument sign 1 foot North of corner monument.


I hereby certify that the corner was perpetuated on July 6, 2009

Witness: Jeff Hsu

REGISTERED
PROFESSIONAL
LAND SURVEYOR

Rick G. Robinson
OREGON
July 17, 1986
RICK G. ROBINSON
2219

Renewal Date: December 31, 2010

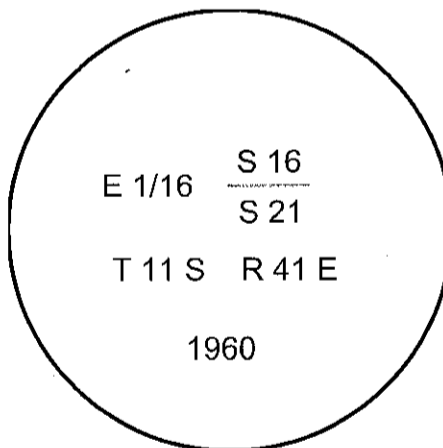

I used a steel tape and magnetic compass in the establishment of the bearing trees. I used 18° East declination. I attached a brass washer marked OPLS 2219 to the BT blaze. The distance is to a 60d spike driven into the root crown at the right side of the new bearing tree and to the center of the aluminum cap on the reference pin.

N-12

FILED Sept. 4, 2009
BAKER COUNTY SURVEYOR
SURVEY NO. 11-41-21