

**CERTIFIED RECORD OF LAND CORNER MONUMENTATION**

**HISTORY OF ORIGINAL CORNER ESTABLISHMENT:**

Originally established by Benjamin Vaughn under GLO Contract No. 211, dated July 14, 1874. Surveyor record states:


Set Stone 25x10x8 for cor to secs 15-16-21 and 22, from which:

A pine 30 in. dia. bears S. 50° E., 150 lks. dist.

Reestablished at proportionate position by C. Albert White under special instructions dated September 3, 1940, included under Group No. 261. Surveyor record states:

Set an iron post, 28 ins. long, 2 ½ ins. diam., 21 ins. in the ground, from which:

- A yellow pine, 8 ins. diam., bears N. 22° E., 16 lks. dist., mkd. T11S R41E S15 BT.
- A yellow pine, 8 ins. diam., bears S. 19° E., 29 lks. dist., mkd. T11S R41E S22 BT.
- A yellow pine, 9 ins. diam., bears S. 34° W., 50 lks. dist., mkd. T11S R41E S21 BT.
- A yellow pine, 18 ins. diam., bears N. 6° W., 65 lks. dist., mkd. T11S R41E S16 BT.

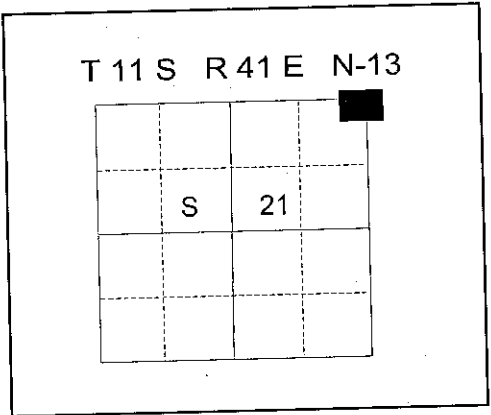

**DESCRIPTION OF CORNER EVIDENCE FOUND:**

Found Bureau of Land Management 3" Brass cap on 2 ½" iron post, protruding 5" above ground, from which:

An 8" pine stump bears North 22° East, a distance of 10.4 feet, with a portion of the tree with visible scribe marks laying alongside.

**DESCRIPTION OF MONUMENT AND ACCESSORIES I ESTABLISHED TO PERPETUATE THE ORIGINAL LOCATION OF THIS CORNER:  
NEW BEARING OBJECTS:**

- A 5/8" iron pin bears North 53° East, a distance of 7.45 feet, with 1 ½" Aluminum cap marked BGB SURVEY MARKER NE RP.
- A 5/8" iron pin bears South 53° East, a distance of 5.00 feet, with 1 ½" Aluminum cap marked BGB SURVEY MARKER SE RP.
- A 5/8" iron pin bears South 77° West, a distance of 9.65 feet, with 1 ½" Aluminum cap marked BGB SURVEY MARKER SW RP.
- A 5/8" iron pin bears North 48° West, a distance of 5.55 feet, with 1 ½" Aluminum cap marked BGB SURVEY MARKER NW RP.

I place a steel fencepost 1 foot North of the corner monument with Land Survey Monument sign attached and steel fencepost beside the iron pin accessories with bearing tree tags.


I hereby certify that the corner was perpetuated on July 6, 2009  
Witness: Jeff Hsu

**REGISTERED  
PROFESSIONAL  
LAND SURVEYOR**

*Rick G. Robinson*

OREGON  
July 17, 1986  
**RICK G. ROBINSON  
2219**

Renewal Date: December 31, 2010

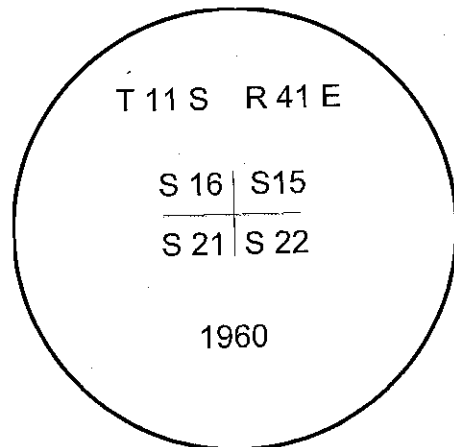

I used a steel tape and magnetic compass in the establishment of the bearing trees. I used 18° East declination. The distance is to the center of the aluminum cap on the reference pins.

FILED Sept. 4, 2009  
BAKER COUNTY SURVEYOR  
SURVEY NO. 11-41-22