


CERTIFIED RECORD OF LAND CORNER MONUMENTATION

HISTORY OF ORIGINAL CORNER ESTABLISHMENT:
Corner not previously established.

DESCRIPTION OF CORNER EVIDENCE FOUND:
None

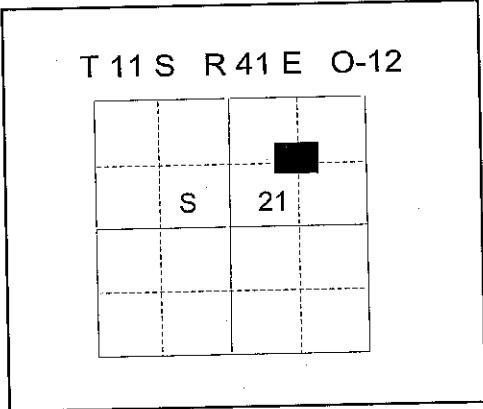

**DESCRIPTION OF MONUMENT AND ACCESSORIES I ESTABLISHED
TO PERPETUATE THE ORIGINAL LOCATION OF THIS CORNER:**

At position determined by survey, I set a USDA Forest Service 2 1/2" x 30" Aluminum pipe, with 3" aluminum cap marked as shown, 27" in the ground, with mound of stone 2 ft. in diameter, from which:

A 13" Ponderosa Pine bears North 89° East, a distance of 49.97 feet, marked NE 1/16 S21 BT.
A 9" Ponderosa Pine bears South 8° East, a distance of 36.40 feet, marked NE 1/16 S21 BT.


Set steel fenceposts 4 feet East and South of corner with US Forest Service Property Boundary signs.

I hereby certify that the corner was monumented on June 29, 2009
Witness: Jeff Hsu, Gregory T. Blackman, Jr.

REGISTERED
PROFESSIONAL
LAND SURVEYOR

OREGON
July 17, 1988
RICK G. ROBINSON
2219

Renewal Date: December 31, 2010

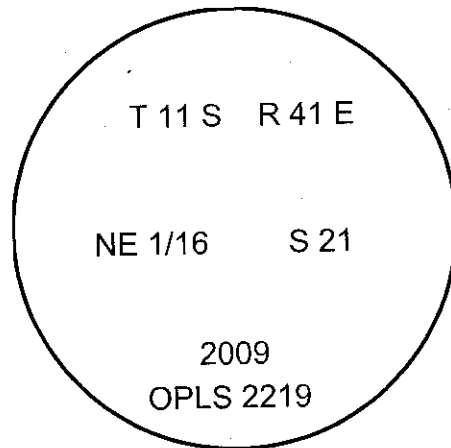

I used a steel tape and magnetic compass in the establishment of the bearing trees. I used 18° East declination. I attached a brass washer marked OPLS 2219 to the BT blaze. The distance is to a 60d spike driven into the root crown at the right side of the new bearing tree.

O-12

FILED Sept. 4, 2009
BAKER COUNTY SURVEYOR
SURVEY NO. 11-41-23