

CERTIFIED RECORD OF LAND CORNER MONUMENTATION


HISTORY OF ORIGINAL CORNER ESTABLISHMENT:

Originally established by C. Albert White under special instructions dated September 3, 1940, included under Group No. 261. Surveyor record states:

Set an iron post, 28 ins. long, 2 ½ ins. diam., 24 ins. in the ground, from which:

A yellow pine, 10 ins. diam., bears S. 86 ½° E., 52 lks. dist., mkd. N 1/16 S22 BT.

A yellow pine, 23 ins. diam., bears S. 45 ½° W., 37 lks. dist., mkd. N 1/16 S21 BT.

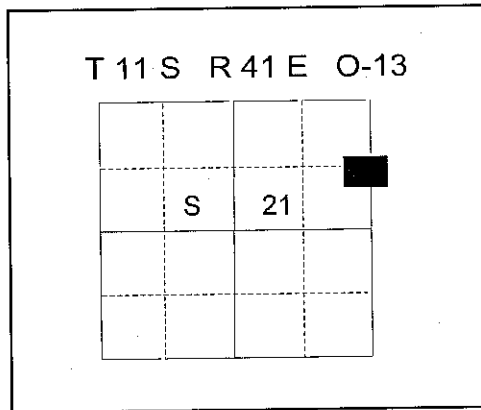

DESCRIPTION OF CORNER EVIDENCE FOUND:

Found Bureau of Land Management 3" Brass cap on 2 ½" iron post, protruding 6" above ground, in rock collar 2 ft. wide, from which:

A 21" pine stump, 6 feet high, bears South 46° West, a distance of 25.23 feet, with visible scribe marks.

DESCRIPTION OF MONUMENT AND ACCESSORIES I ESTABLISHED

TO PERPETUATE THE ORIGINAL LOCATION OF THIS CORNER:

NEW BEARING OBJECTS:

A 10 in. Ponderosa Pine bears North 74° East, a distance of 30.98 feet, marked N 1/16 S22 BT.

An 8 in. Ponderosa Pine bears South 60° East, a distance of 10.64 feet, marked N 1/16 S22 BT.


Set a steel fencepost with Land Survey Monument sign 1 foot West of corner monument.

I hereby certify that the corner was perpetuated on July 6, 2009
Witness: Jeff Hsu

REGISTERED
PROFESSIONAL
LAND SURVEYOR

OREGON
July 17, 1986
RICK G. ROBINSON
2219

Renewal Date: December 31, 2010

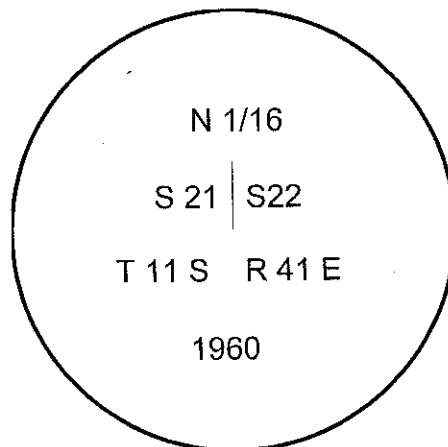

I used a steel tape and magnetic compass in the establishment of the bearing trees. I used 18° East declination. I attached a brass washer marked OPLS 2219 to the BT blaze. The distances are to a 60d spike driven into the root crown at the right side of the new bearing trees.

FILED Sept. 4, 2009
BAKER COUNTY SURVEYOR
SURVEY NO. 11-41-24