

**CERTIFIED RECORD OF LAND CORNER MONUMENTATION**

**HISTORY OF ORIGINAL CORNER ESTABLISHMENT:**

Corner originally established by Benjamin Vaughn under GLO Contract No. 211, dated July 14, 1874. Surveyor record states:

Set Stone 12x10x10 for 1/4 Sec. Cor.

Reestablished at proportionate position by C. Albert White under special instructions dated September 3, 1940, included under Group No. 261. Surveyor record states:

Set an iron post, 28 ins. long, 2 1/2 ins. diam., 22 ins. in the ground, from which:

A fir 8 ins. diam., bears N. 83° E., 15 lks. dist., mkd. 1/4 S20 BT.

A fir, 6 ins. diam., bears N. 69° W., 55 lks. dist., mkd. 1/4 S19 BT.

Recovered by Douglas Ferguson in Survey Number 11-41-10, monumentation records states:

Found 2 1/2" iron pipe with 3" brass cap.  
Fir 15 ins. diam. bears N83E, 5.4 ft., healed blaze.  
Fir 12 ins. diam. bears N69W, 36.3 ft., healed blaze.

W. Fir 12" Diam. Bears S36E, 25.1 ft., scribed 1/4 S20 BT. Set 1/2" x 24" iron pins with aluminum caps as follows: S82-50W, 216.85 ft., stamped 1/4 S19, RM with an arrow and course to the corner.

**DESCRIPTION OF CORNER EVIDENCE FOUND:**

Found Bureau of Land Management 3" Brass cap on 2 1/2" iron post, flush with the ground, from which:

A 17 in. White Fir bears North 83° East, a distance of 5.4 feet, with fully healed blaze.  
A 14 in. White Fir bears South 36° East, a distance of 25.10 feet, with visible scribe marks on partially healed blaze.  
A 16 in. White Fir bears North 86° West, a distance of 36.31 feet, with fully healed blaze.

No search was made for 1/2" iron pin accessory in the Southwest quadrant.

**DESCRIPTION OF MONUMENT AND ACCESSORIES I ESTABLISHED**


**TO PERPETUATE THE ORIGINAL LOCATION OF THIS CORNER:**

**NEW BEARING TREE:**

A 9 in. Ponderosa Pine bears South 49° West, a distance of 78.22 feet, marked 1/4 S19 BT.

I hereby certify that the corner was perpetuated on July 2, 2009

Witness: Jeff Hsu

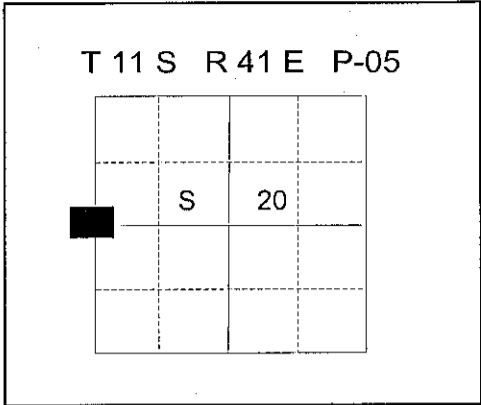


REGISTERED  
PROFESSIONAL  
LAND SURVEYOR

*Rick G. Robinson*

OREGON  
July 17, 1988  
RICK G. ROBINSON  
2219

Renewal Date: December 31, 2010

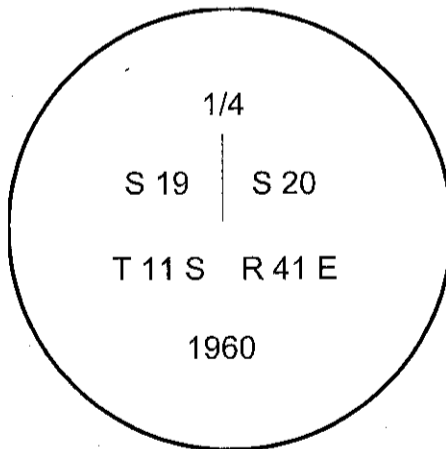

I used a steel tape and magnetic compass in the establishment of the new bearing tree. I used 18° East declination. I attached a brass washer marked OPLS 2219 to the BT blaze. The distance is to a 60d spike driven into the root crown at the right side of the new bearing trees. Bearings and distances to found accessories are to the center of the tree.